


1 LOCATION OF WATER WELL: County: Sherman Fraction: SW 1/4 NW 1/4 SW 1/4 Section Number: 36 Township Number: T 8 S Range Number: R 39 EW

2 WATER WELL OWNER: RR#, St. Address, Box #: 6235 Rd 124 City, State, ZIP Code: Goodland, KS 67735 Board of Agriculture, Division of Water Resources Application Number:

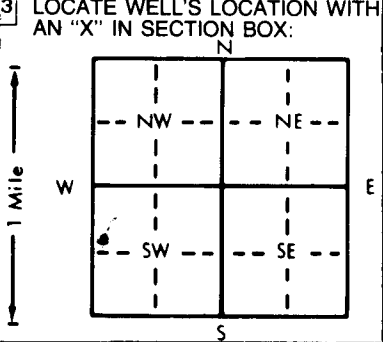

4 DEPTH OF COMPLETED WELL: 275 ft. ELEVATION: 180 ft. below land surface measured on 6-6-96. WELL'S STATIC WATER LEVEL: 180 ft. below land surface measured on 6-6-96.

5 TYPE OF BLANK CASING USED: 1 Steel, 2 PVC, 3 RMP (SR), 4 ABS, 5 Wrought iron, 6 Asbestos-Cement, 7 Fiberglass, 8 Concrete tile, 9 Other, 10 Asbestos-cement. SCREEN OR PERFORATION MATERIAL: 1 Steel, 2 Brass, 3 Stainless steel, 4 Galvanized steel, 5 Fiberglass, 6 Concrete tile, 7 PVC, 8 RMP (SR), 9 ABS, 10 Asbestos-cement, 11 Other, 12 None used (open hole).

6 GROUT MATERIAL: 1 Neat cement, 2 Cement grout, 3 Bentonite, 4 Other. Grout Intervals: From 0 to 20 ft. What is the nearest source of possible contamination: 13 Insecticide storage, 14 Abandoned water well.

Table with columns: FROM, TO, LITHOLOGIC LOG, FROM, TO, PLUGGING INTERVALS. Rows include lithology like Clay, Sand, Sandstone, Sand, Shale and plugging intervals like Bottom Fill with PEA, Gravel, Cement.

7 CONTRACTOR'S OR LANDOWNER'S CERTIFICATION: This water well was (1) constructed, (2) reconstructed, or (3) plugged under my jurisdiction and was completed on 6-6-96 and this record is true to the best of my knowledge and belief. Kansas Water Well Contractor's License No. 484 This Water Well Record was completed on 7-1-96 under the business name of School Drilling Co.