WATER WELL RECORD Form WWC-5 KSA 82a-1212

1 LOCATION OF WATER WELL: County: Sherman | Fraction: NW¼ NE¼ NE¼ | Section Number: 19 | Township Number: T 8 S | Range Number: R 39 E(W)

Distance and direction from nearest town or city street address of well if located within city? SW corner of 9th & Main

2 WATER WELL OWNER: Dave's Auto
RR#, St. Address, Box # : 902 main
City, State, ZIP Code : Goodland, KS 67735
MW#2
Board of Agriculture, Division of Water Resources Application Number:

3 LOCATE WELL'S LOCATION WITH AN "X" IN SECTION BOX:

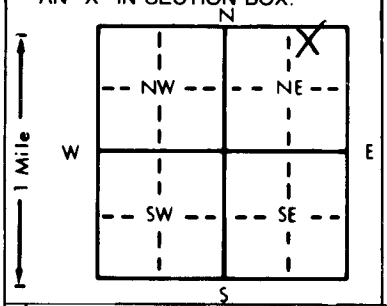


4 DEPTH OF COMPLETED WELL 210 ft. ELEVATION:
Depth(s) Groundwater Encountered 1. ft. 2. ft. 3. ft.
WELL'S STATIC WATER LEVEL 191.27 ft. below land surface measured on mo/day/yr
Pump test data: Well water was ft. after hours pumping gpm
Est. Yield gpm: Well water was ft. after hours pumping gpm
Bore Hole Diameter 8 in. to 210 ft., and in. to ft.
WELL WATER TO BE USED AS: 1 Domestic 2 Irrigation 3 Feedlot 4 Industrial 5 Public water supply 6 Oil field water supply 7 Lawn and garden only 8 Air conditioning 9 Dewatering 10 Monitoring well 11 Injection well 12 Other (Specify below)
Was a chemical/bacteriological sample submitted to Department? Yes No X; If yes, mo/day/yr sample was submitted Water Well Disinfected? Yes No X

5 TYPE OF BLANK CASING USED: 1 Steel 2 PVC 3 RMP (SR) 4 ABS 5 Wrought iron 6 Asbestos-Cement 7 Fiberglass 8 Concrete tile 9 Other (specify below)
CASING JOINTS: Glued Clamped Welded Threaded X
Blank casing diameter 4 in. to 180 ft., Dia in. to ft., Dia in. to ft.
Casing height above land surface 0 in., weight 2.071 lbs./ft. Wall thickness or gauge No. .237
TYPE OF SCREEN OR PERFORATION MATERIAL: 1 Steel 2 Brass 3 Stainless steel 4 Galvanized steel 5 Fiberglass 6 Concrete tile 7 PVC 8 RMP (SR) 9 ABS 10 Asbestos-cement 11 Other (specify) 12 None used (open hole)
SCREEN OR PERFORATION OPENINGS ARE: 1 Continuous slot 2 Louvered shutter 3 Mill slot 4 Key punched 5 Gauzed wrapped 6 Wire wrapped 7 Torch cut 8 Saw cut 9 Drilled holes 10 Other (specify) 11 None (open hole)
SCREEN-PERFORATED INTERVALS: From 180 ft. to 210 ft., From ft. to ft.
From ft. to ft., From ft. to ft.
GRAVEL PACK INTERVALS: From 175 ft. to 210 ft., From ft. to ft.
From ft. to ft., From ft. to ft.

6 GROUT MATERIAL: 1 Neat cement 2 Cement grout 3 Bentonite 4 Other
Grout Intervals: From 0 ft. to 3 ft., From 3 ft. to 175 ft., From ft. to ft.
What is the nearest source of possible contamination: 1 Septic tank 2 Sewer lines 3 Watertight sewer lines 4 Lateral lines 5 Cess pool 6 Seepage pit 7 Pit privy 8 Sewage lagoon 9 Feedyard 10 Livestock pens 11 Fuel storage 12 Fertilizer storage 13 Insecticide storage 14 Abandoned water well 15 Oil well/Gas well 16 Other (specify below) Contaminated Site
Direction from well? How many feet?

| FROM | TO | LITHOLOGIC LOG | FROM | TO | PLUGGING INTERVALS |
|---|---|---|---|---|---|
| 0 | 2 | Surface | 118 | 124 | Semi-Tight Med. Sand w/Clay |
| 2 | 20 | Loess | 124 | 138 | Fine to Med. Sand w/Clay & Some Cement |
| 20 | 30 | Clay & Caliche | | | |
| 30 | 47 | Sandy Clay & Caliche | 138 | 143 | Fine to Med. Sand w/Clay Lns. |
| 47 | 57 | Caliche & Clay | 143 | 158 | Sandy Clay w/Caliche&Some Sand |
| 57 | 66 | Med. Sand & Gravel | 158 | 178 | Med. Sand & Gravel W/Clay Lns. |
| 66 | 69 | Cemented Sand w/Clay & Some Sand | 178 | 179 | Cemented Sand |
| 69 | 74 | Sandy Clay & Caliche | 179 | 180 | Med. Sand & Gravel w/Clay Lyrs. |
| 74 | 84 | Cemented Sand , Clay, Caliche & Some Sand | 180 | 186 | Med. Sand w/Cemented Stks. |
| | | | 186 | 205 | Med. Sand & Gravelw/Fine Clay Lns. |
| 84 | 93 | Fine Sand w/Clay Strks. | 205 | 210 | Cemented Sand w/Clay & Caliche & Some Sand |
| 93 | 98 | Hard Cemented Sand | | | |
| 98 | 102 | Sandy Clay & Caliche | | | |
| 102 | 114 | Med. Sand & Gravel w/Clay Layers | | | |
| 114 | 118 | Sandy Clay | | | |

7 CONTRACTOR'S OR LANDOWNER'S CERTIFICATION: This water well was (1) constructed, (2) reconstructed, or (3) plugged under my jurisdiction and was completed on (mo/day/year) 11-12-97 and this record is true to the best of my knowledge and belief. Kansas Water Well Contractor's License No. 554 This Water Well Record was completed on (mo/day/yr) 11-17-97 under the business name of Woofter Pump & Well, Inc. by (signature)

INSTRUCTIONS: Use typewriter or ball point pen. *PLEASE PRESS FIRMLY* and *PRINT* clearly. Please fill in blanks, underline or circle the correct answers. Send top three copies to Kansas Department of Health and Environment, Bureau of Water, Topeka, Kansas 66620-0001. Telephone: 913-296-5545. Send one to WATER WELL OWNER and retain one for your records.

OFFICE USE ONLY I H E/W SEC ¼ ¼ ¼