


1 LOCATION OF WATER WELL: Fraction Sherman SW 1/4 NE 1/4 SE 1/4 NE 1/4 Section Number 29 Township Number T 8 S Range Number R 39 EW

Distance and direction from nearest town or city street address of well if located within city?  
1802 Sandy Drive Goodland, KS

2 WATER WELL OWNER: Stage Stop Ventures  
 RR#, St. Address, Box #: P.O. Box 575 Board of Agriculture, Division of Water Resources  
 City, State, ZIP Code: Goodland, KS 67735 Application Number:

3 LOCATE WELL'S LOCATION WITH AN "X" IN SECTION BOX: 4 DEPTH OF COMPLETED WELL 217.13 ft. ELEVATION: 706.3065.75

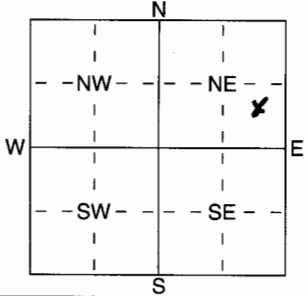

Depth(s) Groundwater Encountered 1 ..... ft. 2 ..... ft. 3 ..... ft.  
 WELL'S STATIC WATER LEVEL 186.90 ft. below land surface measured on mo/day/yr .....  
 Pump test data: Well water was ..... ft. after ..... hours pumping ..... gpm  
 Est. Yield ..... gpm: Well water was ..... ft. after ..... hours pumping ..... gpm  
 WELL WATER TO BE USED AS: 5 Public water supply 8 Air conditioning 11 Injection well  
 1 Domestic 3 Feedlot 6 Oil field water supply 9 Dewatering 12 Other (Specify below)  
 2 Irrigation 4 Industrial 7 Domestic (lawn & garden) 10 Monitoring well NW-6

Was a chemical/bacteriological sample submitted to Department? Yes ..... No X; If yes, mo/day/yr sample was submitted  
 Water Well Disinfected? Yes ..... No

5 TYPE OF BLANK CASING USED: 1 Steel 3 RMP (SR) 5 Wrought iron 8 Concrete tile CASING JOINTS: Glued ..... Clamped .....  
2 PVC 4 ABS 6 Asbestos-Cement 9 Other (specify below) Welded .....  
 7 Fiberglass Threaded X

Blank casing diameter ..... in. to 1.87 ft., Dia ..... in. to ..... ft., Dia ..... in. to ..... ft.  
 Casing height above land surface ..... in., weight ..... lbs./ft. Wall thickness or gauge No. 40

TYPE OF SCREEN OR PERFORATION MATERIAL: 1 Steel 3 Stainless Steel 5 Fiberglass 7 PVC 10 Asbestos-Cement  
 2 Brass 4 Galvanized Steel 6 Concrete tile 8 RMP (SR) 11 Other (Specify) .....  
 9 ABS 12 None used (open hole)

SCREEN OR PERFORATION OPENINGS ARE: 5 Gauzed wrapped 8 Saw cut 11 None (open hole)  
 1 Continuous slot 3 Mill slot 6 Wire wrapped 9 Drilled holes  
 2 Louvered shutter 4 Key punched 7 Torch cut 10 Other (specify) ..... ft.

SCREEN-PERFORATED INTERVALS: From 187 ft. to 217 ft., From ..... ft. to ..... ft.  
 From ..... ft. to ..... ft., From ..... ft. to ..... ft.  
 GRAVEL PACK INTERVALS: From 183 ft. to 217 ft., From ..... ft. to ..... ft.  
 From ..... ft. to ..... ft., From ..... ft. to ..... ft.

6 GROUT MATERIAL: 1 Neat cement 2 Cement grout 3 Bentonite 4 Other .....  
 Grout Intervals: From 0 ft. to 183 ft., From ..... ft. to ..... ft., From ..... ft. to ..... ft.

What is the nearest source of possible contamination: 1 Septic tank 4 Lateral lines 7 Pit privy 11 Fuel storage 14 Abandoned water well  
 2 Sewer lines 5 Cess pool 8 Sewage lagoon 12 Fertilizer storage 15 Oil well/Gas well  
 3 Watertight sewer lines 6 Seepage pit 9 Feedyard 13 Insecticide storage 16 Other (specify below)

Direction from well? How many feet?

| FROM | TO  | LITHOLOGIC LOG                           | FROM | TO | PLUGGING INTERVALS |
|------|-----|--|------|----|--------------------|
| 0    | 40  | silt                                     |      |    |                    |
| 40   | 50  | sandy clay                               |      |    |                    |
| 50   | 80  | sand w/ clay + gravel after 55           |      |    |                    |
| 80   | 90  | gravel + silty sand                      |      |    |                    |
| 90   | 140 | sand w/ gravel, clay + calcite after 110 |      |    |                    |
| 140  | 200 | silty sand w/ clay + calcite             |      |    |                    |
| 200  | 215 | sandy clay w/ calcite                    |      |    |                    |

7 CONTRACTOR'S OR LANDOWNER'S CERTIFICATION: This water well was (1) constructed, (2) reconstructed, or (3) plugged under my jurisdiction and was completed on (mo/day/year) 3/30/05 and this record is true to the best of my knowledge and belief. Kansas Water Well Contractor's Licence No. 554 This Water Well Record was completed on (mo/day/yr) 4/29/05 under the business name of Woolter Pump & Well by (signature) [Signature]