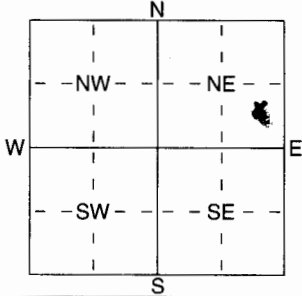


1 LOCATION OF WATER WELL: Fraction		Section Number		Township Number		Range Number	
County: <u>Sherman</u> <u>SW 1/4 NE 1/4 SE 1/4 NE 1/4</u>		<u>29</u>		<u>T 8 S</u>		<u>R 39 E/W</u>	
Distance and direction from nearest town or city street address of well if located within city? <u>1802 Sandy Drive Goodland, KS</u>							
2 WATER WELL OWNER: <u>Stage Stop Ventures</u>							
RR#, St. Address, Box # : <u>PO Box 575</u>				Board of Agriculture, Division of Water Resources			
City, State, ZIP Code : <u>Goodland, KS 67735</u>				Application Number:			
3 LOCATE WELL'S LOCATION WITH AN "X" IN SECTION BOX:		4 DEPTH OF COMPLETED WELL <u>215.40</u> ft. ELEVATION: <u>TOP 3665.30</u>					
		Depth(s) Groundwater Encountered 1 <u>185.50</u> ft. 2 <u>215.40</u> ft. 3 <u>215.40</u> ft.					
		WELL'S STATIC WATER LEVEL <u>185.50</u> ft. below land surface measured on mo/day/yr					
		Pump test data: Well water was <u>185.50</u> ft. after <u>1</u> hours pumping <u>1</u> gpm					
		Est. Yield <u>1</u> gpm: Well water was <u>185.50</u> ft. after <u>1</u> hours pumping <u>1</u> gpm					
WELL WATER TO BE USED AS:		5 Public water supply 8 Air conditioning 11 Injection well					
1 Domestic 3 Feedlot 6 Oil field water supply 9 Dewatering 12 Other (Specify below)		2 Irrigation 4 Industrial 7 Domestic (lawn & garden) <u>10 Monitoring well</u> <u>MW-3</u>					
Was a chemical/bacteriological sample submitted to Department? Yes <u>X</u> No <u>  </u> ; If yes, mo/day/yr sample was submitted							
Water Well Disinfected? Yes <u>  </u> No <u>  </u>							
5 TYPE OF BLANK CASING USED:							
1 Steel 3 RMP (SR) 5 Wrought iron 8 Concrete tile CASING JOINTS: Glued <u>  </u> Clamped <u>  </u>		2 PVC 4 ABS 6 Asbestos-Cement 9 Other (specify below) Welded <u>  </u>					
Blank casing diameter <u>6</u> in. to <u>185</u> ft. Dia <u>  </u> in. to <u>  </u> ft. Dia <u>  </u> in. to <u>  </u> ft.		7 Fiberglass Threaded <u>X</u>					
Casing height above land surface <u>0</u> in., weight <u>  </u> lbs./ft. Wall thickness or gauge No. <u>40</u>							
TYPE OF SCREEN OR PERFORATION MATERIAL:							
1 Steel 3 Stainless Steel 5 Fiberglass 8 RMP (SR) 10 Asbestos-Cement		2 Brass 4 Galvanized Steel 6 Concrete tile 9 ABS 11 Other (Specify) <u>  </u>					
SCREEN OR PERFORATION OPENINGS ARE:							
1 Continuous slot 3 Mill slot 5 Gauzed wrapped 8 Saw cut 11 None (open hole)		2 Louvered shutter 4 Key punched 6 Wire wrapped 9 Drilled holes					
SCREEN-PERFORATED INTERVALS: From <u>185</u> ft. to <u>215</u> ft. From <u>  </u> ft. to <u>  </u> ft.		7 Torch cut 10 Other (specify) <u>  </u> ft.					
GRAVEL PACK INTERVALS: From <u>182</u> ft. to <u>215</u> ft. From <u>  </u> ft. to <u>  </u> ft.							
6 GROUT MATERIAL: 1 Neat cement 2 Cement grout 3 Bentonite 4 Other <u>  </u>							
Grout Intervals: From <u>0</u> ft. to <u>182</u> ft. From <u>  </u> ft. to <u>  </u> ft. From <u>  </u> ft. to <u>  </u> ft.							
What is the nearest source of possible contamination:							
1 Septic tank 4 Lateral lines 7 Pit privy 10 Livestock pens 14 Abandoned water well		2 Sewer lines 5 Cess pool 8 Sewage lagoon 11 Fuel storage 15 Oil well/Gas well					
3 Watertight sewer lines 6 Seepage pit 9 Feedyard 12 Fertilizer storage 16 Other (specify below)		13 Insecticide storage					
Direction from well? How many feet? <u>  </u>							
FROM TO LITHOLOGIC LOG FROM TO PLUGGING INTERVALS							
0 40 silt							
40 70 sand w/ trace gravel							
70 80 silt w/ sand & clay							
80 85 sand - fine to coarse							
85 90 gravel							
90 110 gravelly sand							
110 130 sandy clay w/ caliche & gravel							
130 145 caliche w/ silt - sand							
145 155 sand w/ silt & caliche							
155 160 sandy clay							
160 200 sand w/ silt & trace clay & caliche							
200 215 sandy clay w/ silt & caliche							
7 CONTRACTOR'S OR LANDOWNER'S CERTIFICATION: This water well was (1) constructed, (2) reconstructed, or (3) plugged under my jurisdiction and was completed on (mo/day/year) <u>3/29/05</u> and this record is true to the best of my knowledge and belief. Kansas Water Well Contractor's Licence No <u>554</u> This Water Well Record was completed on (mo/day/yr) <u>4/29/05</u> under the business name of <u>Woofar Pump &amp; Well</u> by (signature) <u>[Signature]</u>							
INSTRUCTIONS: Use typewriter or ball point pen. PLEASE PRESS FIRMLY and PRINT clearly. Please fill in blanks, underline or circle the correct answers. Send top three copies to Kansas Department of Health and Environment, Bureau of Water, Geology Section, 1000 SW Jackson St., Suite 420, Topeka, Kansas 66612-1367. Telephone 785-296-5522. Send one to WATER WELL OWNER and retain one for your records. Fee of \$5.00 for each constructed well.							