


1 LOCATION OF WATER WELL: County: Sherman 091 Fraction: NW 1/4 NW 1/4 NW 1/4 Section Number: 26 Township Number: T 8 S Range Number: R 39 E

Distance and direction from nearest town or city street address of well if located within city?  
2 Miles East, 1/4 Miles South of Goodland

2 WATER WELL OWNER: Edwin R. Deeds  
 RR#, St. Address, Box # : 1308 Harrison Board of Agriculture, Division of Water Resources  
 City, State, ZIP Code : Goodland, Ks. 67735 Application Number:

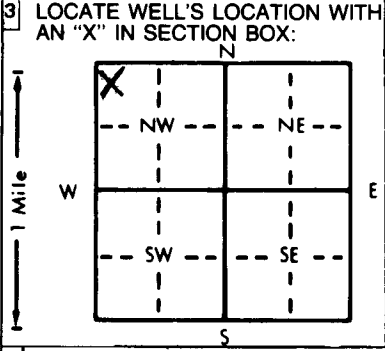

4 DEPTH OF COMPLETED WELL... 288 ft. ELEVATION: .....  
 Depth(s) Groundwater Encountered 1. .... ft. 2. .... ft. 3. .... ft.  
 WELL'S STATIC WATER LEVEL ... 171 ft. below land surface measured on mo/day/yr .....  
 Pump test data: Well water was ..... ft. after ..... hours pumping ..... gpm  
 Est. Yield ..... gpm: Well water was ..... ft. after ..... hours pumping ..... gpm  
 Bore Hole Diameter... 8 in. to ... 288 ft., and, ..... in. to ..... ft.  
 WELL WATER TO BE USED AS: 5 Public water supply 8 Air conditioning 11 Injection well  
1 Domestic 3 Feedlot 6 Oil field water supply 9 Dewatering 12 Other (Specify below)  
2 Irrigation 4 Industrial 7 Lawn and garden only 10 Monitoring well .....  
 Was a chemical/bacteriological sample submitted to Department? Yes.....No...X.....; If yes, mo/day/yr sample was submitted  
 Water Well Disinfected? Yes No X

5 TYPE OF BLANK CASING USED: 5 Wrought iron 8 Concrete tile CASING JOINTS: Glued .. X .. Clamped .....  
1 Steel 3 RMP (SR) 6 Asbestos-Cement 9 Other (specify below) Welded .....  
2 PVC 4 ABS 7 Fiberglass ..... Threaded .....  
 Blank casing diameter ... 4.5 in. to ... 248 ft., Dia ..... in. to ..... ft., Dia ..... in. to ..... ft.  
 Casing height above land surface... 18 in., weight ... 2.38 lbs./ft. Wall thickness or gauge No. ... 248  
 TYPE OF SCREEN OR PERFORATION MATERIAL: 7 PVC 10 Asbestos-cement  
 1 Steel 3 Stainless steel 5 Fiberglass 8 RMP (SR) 11 Other (specify) .....  
 2 Brass 4 Galvanized steel 6 Concrete tile 9 ABS 12 None used (open hole)  
 SCREEN OR PERFORATION OPENINGS ARE: 5 Gauzed wrapped 8 Saw cut 11 None (open hole)  
 1 Continuous slot 3 Mill slot 6 Wire wrapped 9 Drilled holes  
 2 Louvered shutter 4 Key punched 7 Torch cut 10 Other (specify) .....  
 SCREEN-PERFORATED INTERVALS: From ... 248 ft. to ... 288 ft., From ..... ft. to ..... ft.  
 GRAVEL PACK INTERVALS: From ... 20 ft. to ... 288 ft., From ..... ft. to ..... ft.

6 GROUT MATERIAL: 1 Neat cement 2 Cement grout 3 Bentonite 4 Other .....  
 Grout Intervals: From ... 0 ft. to ... 20 ft., From ..... ft. to ..... ft., From ..... ft. to ..... ft.  
 What is the nearest source of possible contamination:  
 1 Septic tank 4 Lateral lines 7 Pit privy 10 Livestock pens 14 Abandoned water well  
 2 Sewer lines 5 Cess pool 8 Sewage lagoon 11 Fuel storage 15 Oil well/Gas well Plugged  
 3 Watertight sewer lines 6 Seepage pit 9 Feedyard 12 Fertilizer storage 16 Other (specify below)  
 13 Insecticide storage  
 Direction from well? Southeast How many feet? 50'

FROM	TO	LITHOLOGIC LOG	FROM	TO	PLUGGING INTERVALS
0	2	Surface	178	197	Med. Sand w/Clay Strks.
2	18	Loess	197	200	Fine to Med. Sand w/Clay Strk
18	46	Clay	200	210	Sandy Clay, Caliche & Sand Strk.
46	50	Clay w/caliche Strks&Sand St.	210	216	Cemented Sand w/Few Clay Strk
50	70	Clay w/Caliche	216	217.5	Med. Sand
70	77	Sandy Clay w/Caliche & S. Sand	217.5	219.5	Cemented Sand w/Clay Strks.
77	85	Med.Sand &Gravel w/Clay Strks	219.5	223	Sandy Clay w/Cemented Strks.
85	96	Sandy Clay w/Caliche	223	224.5	Cemented Sand
96	104	Med.Sand & Gravelw/Clay Strk.	224.5	236	Sandy Clay w/Cemented Sand
104	110	Clay w/Sand Strks.	236	243	Med. Sand w/a Few Clay Strks.
110	129	Clay w/Caliche Strks.	243	246	Sandy Clay w/a Few Caliche St
129	134	Med. Sand w/Clay	246	250	Fine Sand w/Clay Strks.
134	152	Clay & Caliche w/Some Sand	250	255	Cemented Sand w/Clay & Sand
152	155	Med. Sand w/Clay	255	287	Med. Sand w/Caliche & Clay
155	178	Sandy Clay w/Caliche&S.Sand	287	288	Shale

7 CONTRACTOR'S OR LANDOWNER'S CERTIFICATION: This water well was (1) constructed, (2) reconstructed, or (3) plugged under my jurisdiction and was completed on (mo/day/year) ..... 1-12-95 ..... and this record is true to the best of my knowledge and belief. Kansas Water Well Contractor's License No. 554 ..... This Water Well Record was completed on (mo/day/yr) 1-13-95 ..... under the business name of Woofter Pump & Well, Inc. by (signature) [Signature]