

**WATER WELL PLUGGING RECORD Form WWC-5P**

KSA 82a-1212

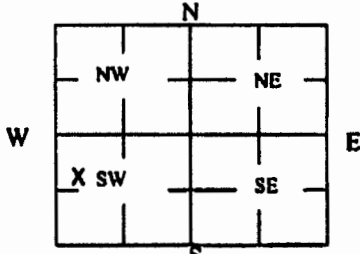
ID NO.

MW-8

|  |                                     |                             |                                 |  |
|--|-------------------------------------|-----------------------------|---------------------------------|--|
| <b>1 LOCATION OF WATER WELL:</b><br>County: <b>Sherman</b> | Fraction<br><b>¼ SE ¼ NW ¼ SW ¼</b> | Section Number<br><b>20</b> | Township Number<br><b>T 8 S</b> | Range Number<br><b>39</b> <input type="checkbox"/> E <input checked="" type="checkbox"/> W |
|--|-------------------------------------|-----------------------------|---------------------------------|--|

|   |   |
|---|---|
| Street/Rural Address of Well Location; if unknown, distance & direction from nearest town or intersection: If at owner's address, check here <input type="checkbox"/> | <b>Global Positioning Systems (GPS) information:</b><br>Latitude: _____ (in decimal degrees)<br>Longitude: _____ (in decimal degrees)<br>Elevation: _____<br>Horizontal Datum: <input type="checkbox"/> WGS84, <input type="checkbox"/> NAD83, <input type="checkbox"/> NAD27<br>Collection Method:<br><input type="checkbox"/> GPS unit (Make/Model: _____)<br><input type="checkbox"/> Digital Map/Photo, <input type="checkbox"/> Topographic Map, <input type="checkbox"/> Land Survey<br>Est. Accuracy: <input type="checkbox"/> < 3 m, <input type="checkbox"/> 3-5 m, <input type="checkbox"/> 5-15 m, <input type="checkbox"/> > 15 m |
|---|---|

|  |
|--|
| <b>2 WATER WELL OWNER:</b> City of Goodland<br>RR#, St. Address, Box #:<br>City, State ZIP Code: <b>Goodland, KS</b> |
|--|

|   |  |
|---|--|
| <b>3 MARK WELL'S LOCATION WITH AN "X" IN SECTION BOX:</b><br> | <b>4 DEPTH OF WELL</b> <u>200.10</u> ft.<br><b>WELL'S STATIC WATER LEVEL</b> <u>DRY</u> ft<br><b>WELL WAS USED AS:</b><br><input type="checkbox"/> Domestic Irrigation <input type="checkbox"/> Public Water Supply <input type="checkbox"/> Dewatering<br><input type="checkbox"/> Feedlot <input type="checkbox"/> Oil Field Water Supply <input checked="" type="checkbox"/> Monitoring <b>MW-8</b><br><input type="checkbox"/> Industrial <input type="checkbox"/> Air Conditioning <input type="checkbox"/> Domestic (Lawn & Garden) <input type="checkbox"/> Injection Well<br><input type="checkbox"/> Other _____<br>Was a chemical/bacteriological sample submitted to Department? Yes <input type="checkbox"/> No <input type="checkbox"/> |
|---|--|

**5 TYPE OF BLANK CASING USED:**

Steel  RMP (SR)  Wrought  Fiberglass  Other (Specify below) \_\_\_\_\_  
 PVC  ABS  Asbestos-Cement  Concrete Tile

Blank casing diameter 4 in. Was casing pulled? Yes  No  If yes, how much 3'  
 Casing height above or below land surface -36 in.

**6 GROUT PLUG MATERIAL:**  Neat cement  Cement grout  Bentonite  Other \_\_\_\_\_

Grout Plug Intervals: From 3 ft. to 200.1 ft., From \_\_\_\_\_ ft. to \_\_\_\_\_ ft., From \_\_\_\_\_ ft. to \_\_\_\_\_ ft.

What is the nearest source of possible contamination:  
 Septic tank  Seepage pit  Fuel storage  Other (specify below) \_\_\_\_\_  
 Sewer lines  Pit privy  Fertilizer storage \_\_\_\_\_  
 Watertight sewer lines  Sewage lagoon  Insecticide storage \_\_\_\_\_  
 Lateral lines  Feedyard  Abandoned water well Direction from well? \_\_\_\_\_  
 Cess pool  Livestock pens  Oil well/Gas well How many feet? \_\_\_\_\_

| FROM | TO    | PLUGGING MATERIALS | FROM | TO | PLUGGING MATERIALS  |
|------|-------|--------------------|------|----|---|
| 0    | 3     | Native Soil        |      |    |   |
| 3    | 200.1 | Bentonite Grout    |      |    |   |
|      |       |                    |      |    | Notes:<br>Goodland Power Plant, 17th & Cherry<br>KDHE/BER project code:U6-091-00682 |
|      |       |                    |      |    |   |
|      |       |                    |      |    |   |

**7 CONTRACTOR'S OR LANDOWNER'S CERTIFICATION:** This water well was plugged under my jurisdiction and was completed on (mo/day/year) 7/13/17 and this record is true to the best of my knowledge and belief. Kansas Water Well Contractor's License No. 881. This Water Well Record was completed on (mo/day/year) 7/24/17 under the business name of Woofter Pump and Well by (signature) 