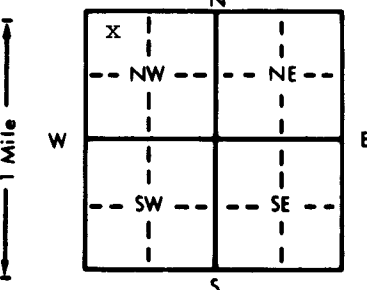
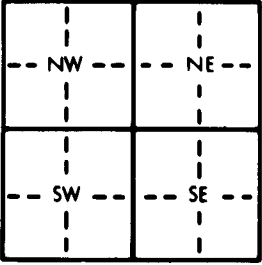


1 LOCATION OF WATER WELL:		Fraction		Section Number		Township Number		Range Number	
County: Sherman		NW 1/4 NW 1/4 NW 1/4		8		T 8 S		R 39 E/W	
Distance and direction from nearest town or city street address of well if located within city?									
Approx. 1 1/2 mi. North of Goodland									
2 WATER WELL OWNER:		City of Goodland							
RR#, St. Address, Box # :		204 W. 11th							
City, State, ZIP Code :		Goodland, KS 67735							
		Board of Agriculture, Division of Water Resources							
		Application Number: 38,060							
3 LOCATE WELL'S LOCATION WITH AN "X" IN SECTION BOX:		4 DEPTH OF COMPLETED WELL: 354 ft. ELEVATION: unknown							
		Depth(s) Groundwater Encountered 1. 136 ft. 2. ft. 3. ft.							
		WELL'S STATIC WATER LEVEL 136 ft. below land surface measured on mo/day/yr 10/17/86							
		Pump test data: Well water was 208 ft. after 5 hours pumping 200-600 gpm							
		Est. Yield 600 gpm: Well water was ft. after hours pumping gpm							
		Bore Hole Diameter 28 in. to 354 ft. and in. to ft.							
		WELL WATER TO BE USED AS:							
		5 Public water supply 8 Air conditioning 11 Injection well							
		1 Domestic 3 Feedlot 6 Oil field water supply 9 Dewatering 12 Other (Specify below)							
		2 Irrigation 4 Industrial 7 Lawn and garden only 10 Observation well							
		Was a chemical/bacteriological sample submitted to Department? Yes X No ; If yes, mo/day/yr sample was submitted 10/27/86							
		Water Well Disinfected? Yes X No							
5 TYPE OF BLANK CASING USED:		CASING JOINTS: Glued Clamped							
1 Steel 3 RMP (SR)		Welded X							
2 PVC 4 ABS		Threaded							
7 Fiberglass									
Blank casing diameter 16 in. to 228 ft. Dia 16		16-294 1/2 in. to 16"-329 3/4 ft.							
Casing height above land surface 48 in. weight 62.6		lbs./ft. Wall thickness or gauge No. 375							
TYPE OF SCREEN OR PERFORATION MATERIAL:		7 PVC 10 Asbestos-cement							
1 Steel 3 Stainless steel 5 Fiberglass 8 RMP (SR) 11 Other (specify)									
2 Brass 4 Galvanized steel 6 Concrete tile 9 ABS 12 None used (open hole)									
SCREEN OR PERFORATION OPENINGS ARE:		5 Gauzed wrapped 8 Saw cut 11 None (open hole)							
1 Continuous slot 3 Mill slot 6 Wire wrapped 9 Drilled holes									
2 Louvered shutter 4 Key punched 7 Torch cut 10 Other (specify) 060 Houston Screen									
SCREEN-PERFORATED INTERVALS:		From 228 ft. to 248 1/2 ft. From 253 1/2 ft. to 273 1/2 ft.							
		From 294 1/2 ft. to 314 3/4 ft. From 329 3/4 ft. to 350 ft.							
GRAVEL PACK INTERVALS:		From 194 ft. to 354 ft. From ft. to ft.							
Annular Fill From 20 ft. to 190 ft. From ft. to ft.									
6 GROUT MATERIAL: A) 1 Neat cement 2 Cement grout B) 3 Bentonite 4 Other									
Grout Intervals: From A) 0 ft. to 20 ft. From A) 192 ft. to 194 ft. From B) 190 ft. to 192 ft.									
What is the nearest source of possible contamination:		10 Livestock pens 14 Abandoned water well							
1 Septic tank 4 Lateral lines 7 Pit privy 11 Fuel storage 15 Oil well/Gas well									
2 Sewer lines 5 Cess pool 8 Sewage lagoon 12 Fertilizer storage 16 Other (specify below)									
3 Watertight sewer lines 6 Seepage pit 9 Feedyard 13 Insecticide storage CREEK									
Direction from well? south		How many feet? approx. 300							
FROM TO LITHOLOGIC LOG		FROM TO LITHOLOGIC LOG							
0 35 Topsoil, clay		202 207		Fine gravel/streak of cemented sand					
35 47 White, tan clayw/caliche streaks		207 221		Red-brown clay/storks fine gravel					
47 64 Fine-med. gravel, streak rock, clay		221 223		Clay/fine-med strks gravel					
64 72 Fine gravel & tan clay/strks		223 227		Fine-Med gravel/brn clay streaks					
72 81 Fine-med gravel		227 237		Med-Coarse gravel					
81 98 Tan, white clay w/strks limestone		237 240		Tan clay/strks hard cemented sand					
98 105 Coarse sand w/thin clay streaks		240 242		Cemented sand					
105 154 Wht, tan clay & clay stone, limestone		242 248		Clay/strks gravel & cemented sand					
154 158 Fine-med. gravelw/strks white clay		248 259		Fine-med. gravel/strks clay & cmtd sand					
158 166 Wht clay w/strks fine gravel		259 261		Cmtd sand-hard/strks f-med. gravel					
166 180 Fine-med gravel strks cmtd sand, clay		261 272		F.grvl/strks cmtd sand & white clay					
180 185 brn sandy clay w/strks cmtd sand		272 288		Cmtd sand/white clay/fine grvl @ 281					
185 195 Fine grvl w/clay strks/cemented sand		288 293		Cmtd sand/F-M grvl/thin clay streaks					
195 200 Reddish - brown clay		293 296		Fine-med. gravel, cemented sand &					
200 202 " " -w/strks fine-med gravel				clay streaks (LOG CONT. NEXT PAGE)					
7 CONTRACTOR'S OR LANDOWNER'S CERTIFICATION: This water well was (1) constructed, (2) reconstructed, or (3) plugged under my jurisdiction and was completed on (mo/day/year) 10/17/86 and this record is true to the best of my knowledge and belief. Kansas									
Water Well Contractor's License No. 185 This Water Well Record was completed on (mo/day/yr) 11/12/86									
under the business name of Clarke Well & Equipment, Inc. by (signature) [Signature]									
INSTRUCTIONS: Use typewriter or ball point pen. PLEASE PRESS FIRMLY and PRINT clearly. Please fill in blanks, underline or circle the correct answers. Send top three copies to Kansas Department of Health and Environment, Office of Oil Field and Environmental Geology, Regulation and Permitting Section, Topeka, Kansas 66620-7500, Telephone: 913-862-9360. Send one to WATER WELL OWNER and retain one for your records.									

<b>1 LOCATION OF WATER WELL:</b>		<b>Fraction</b> County:                      1/4                      1/4                      1/4		<b>Section Number</b>	<b>Township Number</b> T                      S                      R                      E/W
Distance and direction from nearest town or city street address of well if located within city?					
<b>2 WATER WELL OWNER:</b> CITY OF GOODLAND					
RR#, St. Address, Box # :			Board of Agriculture, Division of Water Resources		
City, State, ZIP Code :                      (Lithologic Log Continued . . .)			Application Number:		
<b>3 LOCATE WELL'S LOCATION WITH AN "X" IN SECTION BOX:</b>		<b>4 DEPTH OF COMPLETED WELL</b> . . . . . ft. <b>ELEVATION:</b> . . . . . ft.			
<div style="text-align: center;"></div>		Depth(s) Groundwater Encountered 1. . . . . ft. 2. . . . . ft. 3. . . . . ft.			
		WELL'S STATIC WATER LEVEL . . . . . ft. below land surface measured on mo/day/yr			
		Pump test data: Well water was . . . . . ft. after . . . . . hours pumping . . . . . gpm			
		Est. Yield . . . . . gpm: Well water was . . . . . ft. after . . . . . hours pumping . . . . . gpm			
		Bore Hole Diameter . . . . . in. to . . . . . ft., and . . . . . in. to . . . . . ft.			
WELL WATER TO BE USED AS:		5 Public water supply      8 Air conditioning      11 Injection well			
1 Domestic      3 Feedlot      6 Oil field water supply      9 Dewatering      12 Other (Specify below)					
2 Irrigation      4 Industrial      7 Lawn and garden only      10 Observation well					
Was a chemical/bacteriological sample submitted to Department? Yes . . . . . No . . . . .; If yes, mo/day/yr sample was submitted					
Water Well Disinfected? Yes      No					
<b>5 TYPE OF BLANK CASING USED:</b>		5 Wrought iron      8 Concrete tile		CASING JOINTS: Glued . . . . . Clamped . . . . .	
1 Steel      3 RMP (SR)		6 Asbestos-Cement      9 Other (specify below)		Welded . . . . .	
2 PVC      4 ABS		7 Fiberglass		Threaded . . . . .	
Blank casing diameter . . . . . in. to . . . . . ft., Dia . . . . . in. to . . . . . ft., Dia . . . . . in. to . . . . . ft.					
Casing height above land surface . . . . . in., weight . . . . . lbs./ft. Wall thickness or gauge No. . . . .					
<b>TYPE OF SCREEN OR PERFORATION MATERIAL:</b>					
1 Steel      3 Stainless steel      5 Fiberglass      8 RMP (SR)      11 Other (specify) . . . . .		7 PVC      10 Asbestos-cement			
2 Brass      4 Galvanized steel      6 Concrete tile      9 ABS      12 None used (open hole)					
<b>SCREEN OR PERFORATION OPENINGS ARE:</b>					
1 Continuous slot      3 Mill slot      6 Wire wrapped      9 Drilled holes		5 Gauzed wrapped      8 Saw cut      11 None (open hole)			
2 Louvered shutter      4 Key punched      7 Torch cut      10 Other (specify) . . . . .					
<b>SCREEN-PERFORATED INTERVALS:</b> From . . . . . ft. to . . . . . ft., From . . . . . ft. to . . . . . ft.					
From . . . . . ft. to . . . . . ft., From . . . . . ft. to . . . . . ft.					
<b>GRAVEL PACK INTERVALS:</b> From . . . . . ft. to . . . . . ft., From . . . . . ft. to . . . . . ft.					
From . . . . . ft. to . . . . . ft., From . . . . . ft. to . . . . . ft.					
<b>6 GROUT MATERIAL:</b> 1 Neat cement      2 Cement grout      3 Bentonite      4 Other . . . . .					
Grout Intervals: From . . . . . ft. to . . . . . ft., From . . . . . ft. to . . . . . ft., From . . . . . ft. to . . . . . ft.					
What is the nearest source of possible contamination:					
1 Septic tank      4 Lateral lines      7 Pit privy      10 Livestock pens      14 Abandoned water well		11 Fuel storage      15 Oil well/Gas well			
2 Sewer lines      5 Cess pool      8 Sewage lagoon      12 Fertilizer storage      16 Other (specify below)					
3 Watertight sewer lines      6 Seepage pit      9 Feedyard      13 Insecticide storage					
Direction from well?      How many feet?					
FROM	TO	CONT. . . . . LITHOLOGIC LOG	FROM	TO	LITHOLOGIC LOG
296	301 <sup>23</sup>	Brn clay & cemented sand, very hard cemented sand strk @ 297'	339	348 <sup>13</sup>	Fine gravel, some medium strks sandy clay @ 340, 342, plus a few other thin strks
301	305 <sup>13</sup>	Fine gravel/strks sandy brown clay			
305	309 <sup>23</sup>	Very hard cemented sand & cemented gravel w/strks fine-med gravel & a few thin clay streaks	348	349 <sup>01</sup>	Tan & Lt. green clay
			349	354 <sup>19</sup>	Black shale
309	318 <sup>17</sup>	Fine-med. grvl w/strks very hard cemented sand & cmted grvl @ 309' 311', 314'			
318	335 <sup>01</sup>	Lt. tan & reddish brown clay/strk lt. red shale @ 332'			
335	337 <sup>04</sup>	Lt. green & tan sandy clay w/a few very thin gravel streaks			
337	339 <sup>04</sup>	Lt. green & tan sandy clay & fine gravel			
<b>7 CONTRACTOR'S OR LANDOWNER'S CERTIFICATION:</b> This water well was (1) constructed, (2) reconstructed, or (3) plugged under my jurisdiction and was completed on (mo/day/year) . . . . . SEE PAGE -1- . . . . . and this record is true to the best of my knowledge and belief. Kansas Water Well Contractor's License No. . . . . This Water Well Record was completed on (mo/day/yr) . . . . . under the business name of . . . . . by (signature)					
INSTRUCTIONS: Use typewriter or ball point pen. PLEASE PRESS FIRMLY and PRINT clearly. Please fill in blanks, underline or circle the correct answers. Send top three copies to Kansas Department of Health and Environment, Office of Oil Field and Environmental Geology, Regulation and Permitting Section, Topeka, Kansas 66620-7500, Telephone: 913-862-9360. Send one to WATER WELL OWNER and retain one for your records.					