


1 LOCATION OF WATER WELL: County: Sherman Fraction: 3N 1/4 3N 1/4 3N 1/4 Section Number: 19 Township Number: T 8 S Range Number: R 39 EW

Distance and direction from nearest town or city street address of well if located within city?
Int. of U.S. Hwy 24: Km Hwy 27, Goodland, Kas

2 WATER WELL OWNER: Sherry Jones
 RR#, St. Address, Box #: Box 695 Board of Agriculture, Division of Water Resources
 City, State, ZIP Code: Goodland, Kas 67235 Application Number:

3 LOCATE WELL'S LOCATION WITH AN "X" IN SECTION BOX:

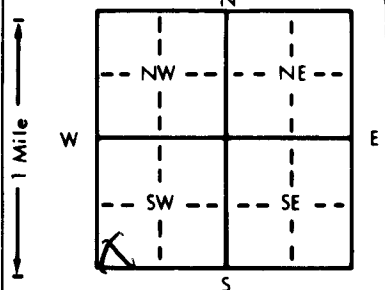

4 DEPTH OF COMPLETED WELL: 210 ft. ELEVATION:

Depth(s) Groundwater Encountered: 1. _____ ft. 2. _____ ft. 3. _____ ft.
 WELL'S STATIC WATER LEVEL: 187 ft. below land surface measured on mo/day/yr
 Pump test data: Well water was _____ ft. after _____ hours pumping _____ gpm
 Est. Yield _____ gpm; Well water was _____ ft. after _____ hours pumping _____ gpm
 Bore Hole Diameter: 7 1/8 in. to _____ ft., and _____ in. to _____ ft.
 WELL WATER TO BE USED AS:
 1 Domestic 3 Feedlot 6 Oil field water supply 9 Dewatering 11 Injection well
 2 Irrigation 4 Industrial 7 Lawn and garden only 16 Monitoring well 12 Other (Specify below)
 Was a chemical/bacteriological sample submitted to Department? Yes _____ No X _____; If yes, mo/day/yr sample was sub-
 mitted _____ Water Well Disinfected? Yes _____ No _____

5 TYPE OF CASING USED:
 1 Steel 3 RMP (SR) 5 Wrought iron 8 Concrete tile CASING JOINTS: Glued _____ Clamped _____
2 PVC 4 ABS 6 Asbestos-Cement 9 Other (specify below) Welded _____
 7 Fiberglass _____ Threaded _____

Blank casing diameter _____ in. to _____ ft., Dia _____ in. to _____ ft., Dia _____ in. to _____ ft.
 Casing height above land surface _____ in., weight _____ lbs./ft. Wall thickness or gauge No. _____

TYPE OF SCREEN OR PERFORATION MATERIAL:
 1 Steel 3 Stainless steel 5 Fiberglass 8 RMP (SR) 10 Asbestos-cement
 2 Brass 4 Galvanized steel 6 Concrete tile 9 ABS 11 Other (specify) _____
 12 None used (open hole)

SCREEN OR PERFORATION OPENINGS ARE:
 1 Continuous slot 3 Mill slot 5 Gauzed wrapped 8 Saw cut 11 None (open hole)
 2 Louvered shutter 4 Key punched 6 Wire wrapped 9 Drilled holes
 7 Torch cut 10 Other (specify) _____

SCREEN-PERFORATED INTERVALS: From 180 ft. to 210 ft., From _____ ft. to _____ ft.
 From _____ ft. to _____ ft., From _____ ft. to _____ ft.
 GRAVEL PACK INTERVALS: From 210 ft. to 175 ft., From _____ ft. to _____ ft.
 From _____ ft. to _____ ft., From _____ ft. to _____ ft.

6 GROUT MATERIAL: 1 Neat cement 2 Cement grout 3 Bentonite 4 Other Vol. Clay
 Grout intervals: From 175 ft. to 0 ft., From _____ ft. to _____ ft., From _____ ft. to _____ ft.

What is the nearest source of possible contamination:
 1 Septic tank 4 Lateral lines 7 Pit privy 10 Livestock pens 14 Abandoned water well
 2 Sewer lines 5 Cess pool 8 Sewage lagoon 11 Fuel storage 15 Oil well/Gas well
 3 Watertight sewer lines 6 Seepage pit 9 Feedyard 12 Fertilizer storage 16 Other (specify below)
 13 Insecticide storage _____

Direction from well? _____ How many feet? _____

| FROM | TO | LITHOLOGIC LOG | FROM | TO | PLUGGING INTERVALS |
|------|-----|-----------------------------|------|-----|------------------------|
| 0 | 15 | Oxterarden & Clay | 165 | 170 | Gravel |
| 15 | 30 | Sandy Clay | 170 | 180 | Stripes of Clay & Sand |
| 30 | 45 | Cemented Sand | 180 | 195 | Gravel Strips & Clay |
| 45 | 50 | Sandy Clay w/ Cemented Sand | 195 | 210 | Gravel |
| 50 | 60 | Clay | | | |
| 60 | 75 | Gravel | | | |
| 75 | 90 | Cemented Sand | | | |
| 90 | 100 | Sandy Clay | | | |
| 100 | 105 | Gravel | | | |
| 105 | 110 | Gravel | | | |
| 110 | 120 | Gravel | | | |
| 120 | 133 | Gravel | | | |
| 133 | 140 | Clay Sand | | | |
| 140 | 150 | Cemented Sand (Hard) | | | |
| 150 | 165 | Gravel | | | |

7 CONTRACTOR'S OR LANDOWNER'S CERTIFICATION: This water well was (1) constructed, (2) reconstructed, or (3) plugged under my jurisdiction and was completed on (mo/day/year) 4. 31. 92 and this record is true to the best of my knowledge and belief Kansas Water Well Contractor's License No. KS 300 This Water Well Record was completed on (mo/day/yr) 5. 11. 92 under the business name of Felder Drilling Co. by (signature) _____