


1 LOCATION OF WATER WELL: County: Sherman Fraction: SW 1/4 SW 1/4 SW 1/4 Section Number: 19 Township Number: T 8 S Range Number: R 39 EW

Distance and direction from nearest town or city street address of well if located within city?
Int of U.S. Hwy 24 & Ks Hwy 27 Goodland, Ks

2 WATER WELL OWNER: Shad, Son
 RR#, St. Address, Box #: Box 645 Board of Agriculture, Division of Water Resources
 City, State, ZIP Code: Goodland, Ks 667 Application Number:

3 LOCATE WELL'S LOCATION WITH AN "X" IN SECTION BOX:

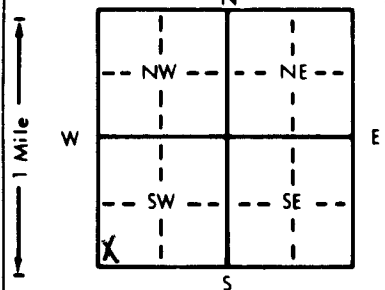

4 DEPTH OF COMPLETED WELL: 210 ft. ELEVATION:
 Depth(s) Groundwater Encountered: 1. _____ ft. 2. _____ ft. 3. _____ ft.
 WELL'S STATIC WATER LEVEL: 187 ft. below land surface measured on mo/day/yr

Pump test data: Well water was _____ ft. after _____ hours pumping _____ gpm
 Est. Yield _____ gpm: Well water was _____ ft. after _____ hours pumping _____ gpm
 Bore Hole Diameter: 7 1/8 in. to _____ ft., and _____ in. to _____ ft.
 WELL WATER TO BE USED AS: 5 Public water supply 8 Air conditioning 11 Injection well
 1 Domestic 3 Feedlot 6 Oil field water supply 9 Dewatering 12 Other (Specify below)
 2 Irrigation 4 Industrial 7 Lawn and garden only 10 Monitoring well
 Was a chemical/bacteriological sample submitted to Department? Yes _____ No X; If yes, mo/day/yr sample was submitted
 Water Well Disinfected? Yes _____ No X

5 TYPE OF CASING USED: 1 Steel 3 RMP (SR) 6 Asbestos-Cement 9 Other (specify below) CASING JOINTS: Glued _____ Clamped _____
2 PVC 4 ABS 7 Fiberglass Welded
Threaded

Blank casing diameter: 4 in. to 180 ft., Dia _____ in. to _____ ft., Dia _____ in. to _____ ft.
 Casing height above land surface: 0.75 ft., weight _____ lbs./ft. Wall thickness or gauge No. _____

TYPE OF SCREEN OR PERFORATION MATERIAL: 1 Steel 3 Stainless steel 5 Fiberglass 8 RMP (SR) 10 Asbestos-cement
 2 Brass 4 Galvanized steel 6 Concrete tile 9 ABS 11 Other (specify) _____
 SCREEN OR PERFORATION OPENINGS ARE: 5 Gauzed wrapped 8 Saw cut 11 None (open hole)
 1 Continuous slot 3 Mill slot 6 Wire wrapped 9 Drilled holes
 2 Louvered shutter 4 Key punched 7 Torch cut 10 Other (specify) _____

SCREEN-PERFORATED INTERVALS: From 180 ft. to 210 ft., From _____ ft. to _____ ft.
 From _____ ft. to _____ ft., From _____ ft. to _____ ft.
 GRAVEL PACK INTERVALS: From 210 ft. to 175 ft., From _____ ft. to _____ ft.
 From _____ ft. to _____ ft., From _____ ft. to _____ ft.

6 GROUT MATERIAL: 1 Neat cement 2 Cement grout 3 Bentonite 4 Other: Vol Clay
 Grout Intervals: From 175 ft. to 0 ft., From _____ ft. to _____ ft., From _____ ft. to _____ ft.

What is the nearest source of possible contamination:
 1 Septic tank 4 Lateral lines 7 Pit privy 10 Livestock pens 14 Abandoned water well
 2 Sewer lines 5 Cess pool 8 Sewage lagoon 11 Fuel storage 15 Oil well/Gas well
 3 Watertight sewer lines 6 Seepage pit 9 Feedyard 12 Fertilizer storage 16 Other (specify below) _____
 13 Insecticide storage _____
 Direction from well? _____ How many feet? _____

FROM	TO	LITHOLOGIC LOG	FROM	TO	PLUGGING INTERVALS
0	10	Orestudon: Clay	140	150	Cemented Sand: Clay Strips
10	30	Sandy Clay	150	160	Gravel
30	45	Cemented Clay	160	170	Gravel
45	50	Coliche	170	180	Striped Clay: Sand
50	60	Sandy Clay/Cemented Sand = Small Strips of Sand	180	190	Striped Gravel: Clay
60	70	Clay	190	210	Gravel
70	75	Gravel			
75	80	Gravel			
80	90	Cemented Sand (Hard)			KDHE Code# 00091225
90	100	Sandy Clay			MW # 4
100	105	Sandy Gravel			
105	110	Gravel			
110	133	Gravel			
133	140	Clay			

7 CONTRACTOR'S OR LANDOWNER'S CERTIFICATION: This water well was (1) constructed, (2) reconstructed, or (3) plugged under my jurisdiction and was completed on (mo/day/year) 4-29-92 and this record is true to the best of my knowledge and belief. Kansas Water Well Contractor's License No. KS-300 This Water Well Record was completed on (mo/day/yr) 5-11-92 under the business name of Fulter Drilling Co. by (signature) [Signature]