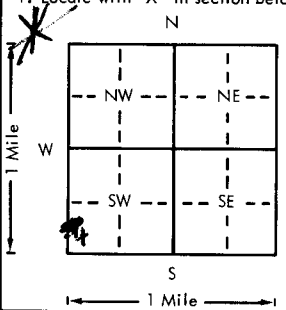
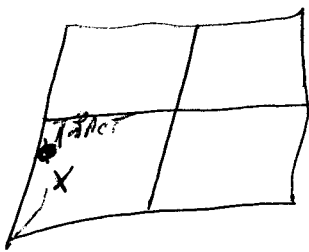


USE TYPEWRITER OR BALL POINT PEN-PRESS FIRMLY, PRINT CLEARLY.

WATER WELL RECORD  
KSA 82a-1201-1215

Kansas Department of Health and Environment-Division of Environment  
(Water well Contractors)  
Topeka, Kansas 66620

OCC

1. Location of well: County <b>SHERMAN</b>		Fraction <b>SW 1/4 SW 1/4 SW 1/4</b>		Section number <b>21</b>		Township number T <b>8</b> S <b>3</b> R <b>9</b> EW		Range number <b>39</b>	
2. Distance and direction from nearest town or city: <b>1 mile EAST OF HOODLAND</b>				3. Owner of well: <b>Bill Cole</b> R.R. or street: <input checked="" type="checkbox"/> <b>HOODLAND, KANSAS 67735</b>					
4. Locate with "X" in section below:		Sketch map:				6. Bore hole dia. <b>12</b> in. Completion date <b>10/16/78</b> Well depth <b>301</b> ft.			
						7. <input checked="" type="checkbox"/> Cable tool <input checked="" type="checkbox"/> Rotary <input type="checkbox"/> Driven <input type="checkbox"/> Dug <input type="checkbox"/> Hollow rod <input type="checkbox"/> Jetted <input type="checkbox"/> Bored <input type="checkbox"/> Reverse rotary			
5. Type and color of material		From		To		8. Use: <input checked="" type="checkbox"/> Domestic <input type="checkbox"/> Public supply <input type="checkbox"/> Industry <input type="checkbox"/> Irrigation <input type="checkbox"/> Air conditioning <input type="checkbox"/> Stock <input type="checkbox"/> Lawn <input type="checkbox"/> Oil field water <input type="checkbox"/> Other			
<b>Clay Gravel &amp; Sandstone</b>		<b>0</b>		<b>179</b>		9. Casing: Material <b>Steel</b> Height <b>Above</b> or below Threaded <input checked="" type="checkbox"/> Welded <input type="checkbox"/> Surface <b>12</b> in. RMP <input type="checkbox"/> PVC <input type="checkbox"/> Weight <b>22</b> lbs./ft. Dia. <b>12</b> in. to <b>281</b> ft. depth Wall Thickness: inches or Dia. <input type="checkbox"/> in. to <input type="checkbox"/> ft. depth gage No. <b>168</b>			
<b>Fine Sand</b>		<b>179</b>		<b>206</b>		10. Screen: Manufacturer's name <b>DORROR</b> Type <b>mill slot</b> Dia. <b>4 1/2</b> Slot/gauge <input type="checkbox"/> Length <b>20'</b> Set between <b>281</b> ft. and <b>301</b> ft. ft. and <input type="checkbox"/> ft. Gravel pack? <input checked="" type="checkbox"/> Size range of material <b>1/8" x 3/16"</b>			
<b>Sandstone &amp; Sandyclay</b>		<b>206</b>		<b>237</b>		11. Static water level: <input type="checkbox"/> mo./day/yr. <b>179</b> ft. below land surface Date <b>10/16/78</b>			
<b>Gravel</b>		<b>237</b>		<b>263</b>		12. Pumping level below land surfaces: <b>200</b> ft. after <b>8</b> hrs. pumping <b>13</b> g.p.m. <input type="checkbox"/> ft. after <input type="checkbox"/> hrs. pumping <input type="checkbox"/> g.p.m. Estimated maximum yield <b>25</b> g.p.m.			
<b>Sandstone</b>		<b>263</b>		<b>269</b>		13. Water sample submitted: <input type="checkbox"/> mo./day/yr. Yes <input checked="" type="checkbox"/> No <input type="checkbox"/> Date <input type="checkbox"/>			
<b>Gravel</b>		<b>269</b>		<b>283</b>		14. Well head completion: <input checked="" type="checkbox"/> Pitless adapter <b>12</b> Inches above grade			
<b>Soapstone</b>		<b>283</b>		<b>296</b>		15. Well grouted? <input checked="" type="checkbox"/> With: <input checked="" type="checkbox"/> Neat cement <input type="checkbox"/> Bentonite <input type="checkbox"/> Concrete Depth: From <b>4</b> ft. to <b>14</b> ft.			
<b>Shale</b>		<b>296</b>		<b>301</b>		16. Nearest source of possible contamination: ft. <input type="checkbox"/> Direction <b>NW</b> Type <input type="checkbox"/> Well disinfected upon completion? <input checked="" type="checkbox"/> Yes <input type="checkbox"/> No			
						17. Pump: Not installed Manufacturer's name <b>Howlds</b> Model number <b>10515</b> HP <b>1 1/2</b> Volts <b>230</b> Length of drop pipe <b>250</b> ft. capacity <b>10</b> g.p.m. Type: <input checked="" type="checkbox"/> Submersible <input type="checkbox"/> Turbine <input type="checkbox"/> Jet <input type="checkbox"/> Reciprocating <input type="checkbox"/> Centrifugal <input type="checkbox"/> Other			
						(Use a second sheet if needed)			
18. Elevation:		19. Remarks: <b>Cement WAS Run By. Foust Supply Co Inc.</b>							
Topography: <input type="checkbox"/> Hill <input checked="" type="checkbox"/> Slope <input type="checkbox"/> Upland <input type="checkbox"/> Valley		20. Water well contractor's certification: This well was drilled under my jurisdiction and this report is true to the best of my knowledge and belief. <b>Foust Supply Co Inc 144</b> Business name <b>HOODLAND, KANSAS 67735</b> License No. <b>144</b> Address <b>Ralph E. Foust mgr</b> Date <b>11-24-78</b> Signed <b>Ralph E. Foust mgr</b> Authorized representative							

T 8 39 21 Sec