

USE TYPEWRITER OR BALL POINT PEN-PRESS FIRMLY, PRINT CLEARLY.

T R EW sec 1/4 1/4 1/4 No.


WATER WELL RECORD
KSA 82a-1201-1215

Kansas State Dept. Of Health
(Water Well Contractors)
Forbes-Bldg. 740
Topeka, Kansas 66620

ADD DCD

1 Location of well:	County Sherman	Township name Itasco	Fraction SE$\frac{1}{4}$ SW$\frac{1}{4}$ NE$\frac{1}{4}$	Section number 26	Town number 8 S	Range number 39 W
---------------------	--------------------------	--------------------------------	---	-----------------------------	---------------------------	-----------------------------

Distance and direction from nearest town or city: 4 S of Goodland	3 Owner of well: Lawrence House
Street address of well location if in city:	Address: Goodland, Kansas 67735 Route #2 Box 100

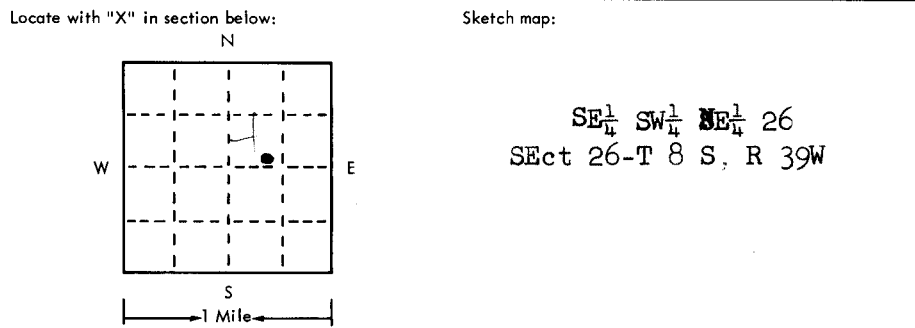

4 Well depth: 280 ft. Date of completion 2-21-75
Well diameter 30 in.

5 Cable tool Rotary Driven Dug
 Hollow rod Jetted Bored Reverse rotary

6 Use: Domestic Public supply Industry
 Irrigation Air conditioning Commercial
 Test well

7 Casing: Material steel Height: above/below
Threaded Welded Surface 12 in.
Diam. 16 in. Weight 36 lbs./ft.
16 in. to 280 ft. depth Drive shoe? Yes No
 in. to ft. depth!

2	Type and color of material	From	To
	sand, sandy clay, and clay	0	104
	sand	104	107
	sandy clay	107	126
	medium sand	126	131
	sandy clay	131	139
	medium to good sand	139	152
	sandstone streaks, sand, clay	152	160
	sandy clay	160	171
	good sand	171	175
	sandy clay	175	213
	medium sand	213	217
	tight, sandy clay, streaks sandrock	217	221
	good sand	221	234
	sand, sandy clay	234	247
	medium fine sand	247	267
	XX good sand	267	278
	soapstone (use a second sheet if needed)	278	280

8 Screen: none
Manufacturer Sargent Irrigation
Type steel Dia. 16"
Slot gauze 2" Length 60
Set between 220 ft. and 280 ft.
Fittings:
Gravel pack Yes No Size range of material 3/16

9 Static water level:
114 ft. below land surface Date 2-23-75

10 Pumping level below land surfaces:
124 ft. after 70 hrs. pumping 800 g.p.m.
 ft. after hrs. pumping g.p.m.
Estimated maximum yield 1000 g.p.m.

11 Water sample submitted:
 Yes No Date

12 Well head completion:
 Pitless adapter Inches above grade 12"

13 Well grouted? Yes No
 Neat cement sandy clay
Depth: From 0 ft. to 1 ft.

14 Nearest source of possible contamination: none
ft. Direction Type
Well disinfected upon completion? Yes No

15 Pump: Not installed
Manufacturer's name BJ Byron Jackson
Model number Turbine 82 Volts
Length of drop pipe 270 ft. capacity 800 g.m.p.
Type:
 Submersible Turbine
 Jet Reciprocating
 Centrifugal Other

16 Remarks: elevation 3625 (TOP) BRICK 3/8'

Topography:
 Hill
 Slope
 Upland
 Valley

17 Water well contractor's certification:
This well was drilled under my jurisdiction and this report is true to the best of my knowledge and belief.
Northwest Drilling Co. 248
Business name Scott City, Kansas License No.
Address
Signed Ben Harz Date 4-75
Authorized representative 4-30-75