


1 LOCATION OF WATER WELL: Fraction SE 1/4 NW 1/4 NW 1/4 Section Number 26 Township Number T 8 S Range Number R 39 EW

Distance and direction from nearest town or city street address of well if located within city?
 3 MILES EAST AND 1/2 MILE SOUTH OF GOODLAND, KANSAS

2 WATER WELL OWNER: EDWIN R DEEDS
 RR#, St. Address, Box #: 1308 HARRISON Board of Agriculture, Division of Water Resources
 City, State, ZIP Code: GOODLAND, KS 67735 Application Number:

3 LOCATE WELL'S LOCATION WITH AN "X" IN SECTION BOX:

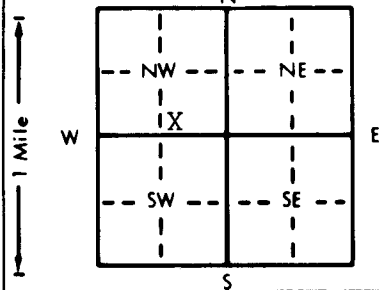

4 DEPTH OF COMPLETED WELL: 292 ft. ELEVATION:
 Depth(s) Groundwater Encountered 1. ft. 2. ft. 3. ft.
 WELL'S STATIC WATER LEVEL . 176. ft. below land surface measured on mo/day/yr
 Pump test data: Well water was ft. after hours pumping gpm
 Est. Yield gpm: Well water was ft. after hours pumping gpm
 Bore Hole Diameter in. to ft., and in. to ft.
 WELL WATER TO BE USED AS: 5 Public water supply 8 Air conditioning 11 Injection well
 1 Domestic 3 Feedlot 6 Oil field water supply 9 Dewatering 12 Other (Specify below)
 ② Irrigation 4 Industrial 7 Lawn and garden only 10 Monitoring well
 Was a chemical/bacteriological sample submitted to Department? Yes No ; If yes, mo/day/yr sample was sub-
 mitted Water Well Disinfected? Yes No

5 TYPE OF BLANK CASING USED: 5 Wrought iron 8 Concrete tile CASING JOINTS: Glued Clamped
 ① Steel 3 RMP (SR) 6 Asbestos-Cement 9 Other (specify below) Welded
 2 PVC 4 ABS 7 Fiberglass Threaded

Blank casing diameter 16 . . . in. to 192 . . . ft., Dia in. to ft., Dia in. to ft.
 Casing height above land surface . . 12 in., weight 219 lbs./ft. Wall thickness or gauge No.

TYPE OF SCREEN OR PERFORATION MATERIAL: 7 PVC 10 Asbestos-cement
 ① Steel 3 Stainless steel 5 Fiberglass 8 RMP (SR) 11 Other (specify)
 2 Brass 4 Galvanized steel 6 Concrete tile 9 ABS 12 None used (open hole)

SCREEN OR PERFORATION OPENINGS ARE: 5 Gauzed wrapped 8 Saw cut 11 None (open hole)
 1 Continuous slot ③ Mill slot 6 Wire wrapped 9 Drilled holes
 2 Louvered shutter 4 Key punched 7 Torch cut 10 Other (specify)

SCREEN-PERFORATED INTERVALS: From . . . 192 ft. to . . . 292 ft., From ft. to ft.
 From ft. to ft., From ft. to ft.
 GRAVEL PACK INTERVALS: From . . . 0 ft. to . . . 292 ft., From ft. to ft.
 From ft. to ft., From ft. to ft.

6 GROUT MATERIAL: 1 Neat cement 2 Cement grout ③ Bentonite 4 Other
 Grout intervals: From . . . 6 ft. to . . . 3 ft., From ft. to ft., From ft. to ft.

What is the nearest source of possible contamination:
 1 Septic tank 4 Lateral lines 7 Pit privy 10 Livestock pens 14 Abandoned water well
 2 Sewer lines 5 Cess pool 8 Sewage lagoon 11 Fuel storage 15 Oil well/Gas well
 3 Watertight sewer lines 6 Seepage pit 9 Feedyard 12 Fertilizer storage 16 Other (specify below)
 13 Insecticide storage FARMSTED

Direction from well? WEST How many feet? 5000

FROM	TO	LITHOLOGIC LOG	FROM	TO	PLUGGING INTERVALS
			292	150	WASHED SAND W/CHLORINE
			150	6	CLAY
			6	3	BENTONITE
			3	0	TOP SOIL
		THIS WELL REPLACED BY REDRILL 295' WEST			

7 CONTRACTOR'S OR LANDOWNER'S CERTIFICATION: This water well was (1) constructed, (2) reconstructed, or (3) plugged under my jurisdiction and was completed on (mo/day/year) . . 01/10/94 and this record is true to the best of my knowledge and belief. Kansas Water Well Contractor's License No. . . 507 This Water Well Record was completed on (mo/day/yr) under the business name of Western Sprinklers, Inc. by (signature) Edwin R Deeds