

USE TYPEWRITER OR BALL POINT PEN-PRESS FIRMLY, PRINT CLEARLY.

WATER WELL RECORD
KSA 82a-1201-1215


Kansas Department of Health and Environment-Division of Environment
(Water well Contractors)
Topeka, Kansas 66620

BBD

1. Location of well: County **SHERMAN** Fraction **SE 1/4 NW 1/4 NW 1/4** Section number **29** Township number **T 8 S R 39** Range number **39** ~~XXX~~

2. Distance and direction from nearest town or city: **1/4 mile south of Goodland, KS**
Street address of well location if in city: **Armstrong Addition**

3. Owner of well: **Mike Burk**
R.R. or street: **Route 2**
City, state, zip code: **Goodland, KS 67735**

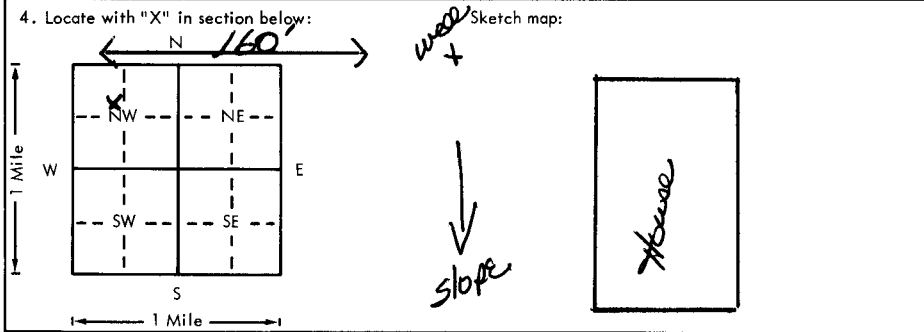

6. Bore hole dia. **8** in. Completion date _____
Well depth **300** ft.

7. Cable tool Rotary Driven Dig
 Hollow rod Jetted Bored Reverse rotary

8. Use: Domestic Public supply Industry
 Irrigation Air conditioning Stock
 Lawn Oil field water Other

9. Casing: Material **plastic** Height: Above or below **max**
Threaded Welded Surface **12** in.
RMP PVC Weight _____ lbs./ft.
Dia. **4** in. to **276** ft. depth Wall Thickness: inches or
Dia. _____ in. to _____ ft. depth Gauge No. **237**

5. Type and color of material	From	To
Topsoil	0	4
Clay	4	56
M. Gravel, Clay	56	86
M. Gravel, Big gravel	86	98
Hard Sand stone	98	104
M. Gravel	104	111
Sandy Clay	111	130
M. Gravel, sandy clay, sand stone	130	152
M. Gravel, gravel	152	194
Sandy clay	194	197
M. Gravel, gravel, sandy clay, sand stone	197	249
M. gravel	249	252
M. gravel, sandy clay, sand stone	252	256
M. Gravel	256	260
M. gravel, sandy clay, sand stone	260	264
M. gravel	264	269
M. gravel, sand stone	269	271
M. gravel	271	275
Fine sand, M. gravel, sandy clay	275	286
M. Gravel	286	293
Shale	293	300

10. Screen: Manufacturer's name **Peerless**
Type **Lower** Dia. **5"**
Slot/gauze **1/8 .258** Length **24'**
Set between **276** ft. and **300** ft.
ft. and _____ ft.
Gravel pack? **yes** Size range of material **1/8**

11. Static water level: _____ mo./day/yr.
192 ft. below land surface Date **3-3-80**

12. Pumping level below land surfaces:
215 ft. after **4** hrs. pumping **17** g.p.m.
_____ ft. after _____ hrs. pumping _____ g.p.m.
Estimated maximum yield **55** g.p.m.

13. Water sample submitted: _____ mo./day/yr.
 Yes No Date _____

14. Well head completion:
 Pitless adapter **12** Inches above grade

15. Well grouted? **yes**
With: Neat cement Bentonite Concrete
Depth: From **5** ft. to **15** ft.

16. Nearest source of possible contamination:
ft. **160** Direction **West** Type **cesspool**
Well disinfected upon completion? Yes No

17. Pump: Not installed
Manufacturer's name _____
Model number _____ HP _____ Volts _____
Length of drop pipe _____ ft. capacity _____ g.p.m.
Type:
 Submersible Turbine
 Jet Reciprocating
 Centrifugal Other

18. Elevation: _____
19. Remarks: **Shale**

Topography:
 Hill
 Slope
 Upland
 Valley

BRock 293
192
160 and **111**

20. Water well contractor's certification:
This well was drilled under my jurisdiction and this report is true to the best of my knowledge and belief.

S & H Drilling Co. License No. **166**
Business name
Address **Goodland, KS 67735**
Signed **Bill Puffo** Date **4-28-80**
Authorized representative

T-8-390
 R-390
 E-390
 S-29
 SE-111
 1/4 1/4 80 1/4