

USE TYPEWRITER OR BALL POINT PEN-PRESS FIRMLY, PRINT CLEARLY.


WATER WELL RECORD  
KSA 82a-1201-1215

Kansas Department of Health and Environment-Division of Environment  
(Water well Contractors)  
Topeka, Kansas 66620

B3BA

1. Location of well: County SHERMAN Fraction NE 1/4 NW 1/4 NW 1/4 Section number 31 Township number T 8 S R 29 E N

2. Distance and direction from nearest town or city: 1 1/2 E  
Street address of well location if in city: GOODLAND  
3. Owner of well: EDMUND R. Bengin  
R.R. or street: HWY 27  
City, state, zip code: GOODLAND, KANSAS, 67735

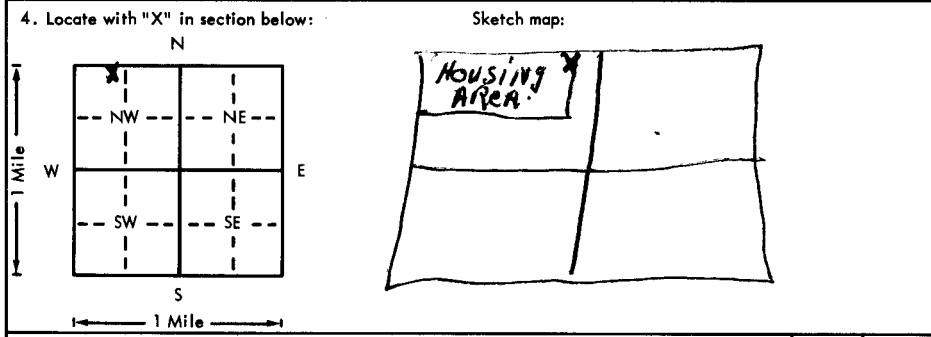

6. Bore hole dia. 10" in. Completion date 4-2-76  
Well depth 285 ft.  
7.  Cable tool  Rotary  Driven  Dug  
 Hollow rod  Jetted  Bored  Reverse rotary  
8. Use:  Domestic  Public supply  Industry  
 Irrigation  Air conditioning  Stock  
 Lawn  Oil field water  Other  
9. Casing: Material Steel Height: Above or below  
Threaded  Welded  Surface 12 in.  
RMP  PVC  Weight 22 lbs./ft.  
Dia. 12 in. to 285 ft. depth Wall Thickness: inches or  
Dia.     in. to     ft. depth gage No. 188

5. Type and color of material	From	To
Top Soil	0	3
Clay Sandstone & Gravel	3	170
Gravel	170	174
Clay & Sandstone	174	221
Gravel	221	228
Clay & Sandstone	228	252
Gravel	252	256
Clay	256	260
Gravel	260	268
Sandstone	268	273
Gravel	273	276
Soapstone	276	285
Shale	285	
(Use a second sheet if needed)		

10. Screen: Manufacturer's name DOBERN  
Type mill/solt Dia. 4 1/2"  
Slot/gauze 48 Length 20'  
Set between 265 ft. and 285 ft.  
Gravel pack?  Size range of material 44"  
11. Static water level: 170 ft. below land surface Date 4-9-76  
12. Pumping level below land surfaces:  
    ft. after     hrs. pumping     g.p.m.  
    ft. after     hrs. pumping     g.p.m.  
Estimated maximum yield 10 g.p.m.  
13. Water sample submitted:     mo./day/yr.  
 Yes  No Date      
14. Well head completion:  
 Pitless adapter     Inches above grade  
15. Well grouted?   
With:  Neat cement  Bentonite  Concrete  
Depth: From 266 ft. to 16 ft. Blow  
16. Nearest source of possible contamination:  
ft.     Direction NO NE Type      
Well disinfected upon completion?  Yes  No  
17. Pump:  Not installed  
Manufacturer's name GOUIDS  
Model number 13E00 HP 1 1/2 Volts 230  
Length of drop pipe 267 ft. capacity 10 g.p.m.  
Type:  
 Submersible  Turbine  
 Jet  Reciprocating  
 Centrifugal  Other

18. Elevation:  
Topography:  
 Hill  
 Slope  
 Upland  
 Valley

19. Remarks:  
BROCK 276'

20. Water well contractor's certification:  
This well was drilled under my jurisdiction and this report is true to the best of my knowledge and belief.  
Frost Supply Co. Inc. 144  
Business name Box 338 License No.      
Address      
Signed Ralph Elmman Date 4-9-76  
Authorized representative

T 8 R 29 E N  
1/4 1/4 1/4 1/4