

USE TYPEWRITER OR BALL POINT PEN-PRESS FIRMLY, PRINT CLEARLY.

T R EW sec 1/4 1/4 1/4 No.


WATER WELL RECORD
KSA 82a-1201-1215

Kansas State Dept. Of Health
(Water Well Contractors)
Forbes-Bldg. 740
Topeka, Kansas 66620

BCD

1 Location of well: County Sherman Township name Itasca Fraction SE 1/4 Section number 31 Town number 8 Range number 39

Distance and direction from nearest town or city: Goodland 15
Street address of well location if in city:
3 Owner of well: BURT McILWAY
Address: Goodland Kansas

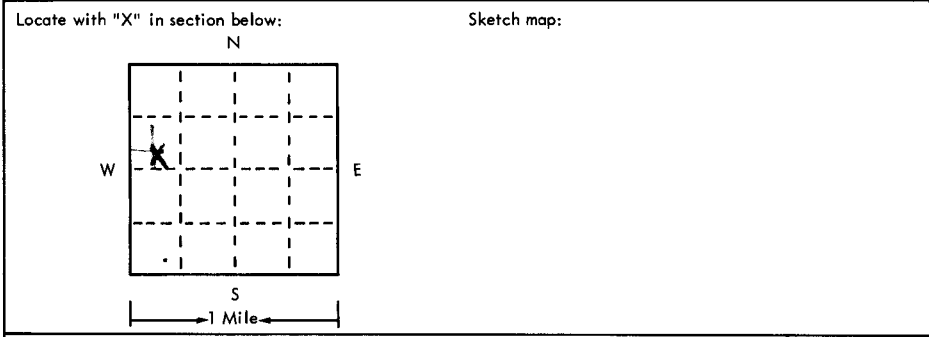

4 Well depth: 220 ft. Date of completion 6-10-75
Well diameter 8 in.
5 Cable tool Rotary Driven Dug
 Hollow rod Jetted Bored Reverse rotary
6 Use: Domestic Public supply Industry
 Irrigation Air conditioning Commercial
 Test well
7 Casing: Material Plastic Height: above/below
Threaded Welded Surface 12 in.
Diam. 4 in. to 220 ft. depth Drive shoe? Yes No
Weight 200 lbs./ft. 4 in. to 220 ft. depth

2	Type and color of material	From	To
	GRAVEL	165	172
	M GRAVEL, SANDY CLAY	172	177
	SANDY CLAY	177	181
	M GRAVEL, SANDY CLAY	181	190
	GRAVEL, SANDY CLAY, SANDSTONE	190	217
	M GRAVEL	217	223
	GRAVEL, SANDSTONE	223	231
	GRAVEL	231	233
	M GRAVEL, SANDSTONE	233	257
	GRAVEL	257	261
	SANDSTONE	261	263
	GRAVEL	263	268
	CLAY	268	270
	(use a second sheet if needed)		

8 Screen: Manufacturer Jess Howell
Type Lucer Dia. 4
Slot/gauze 1/8, 200 Length 12
Set between 258 ft. and 270 ft.
Fittings: Gravel pack Yes No Size range of material 1/4
9 Static water level: 167 ft. below land surface Date 6-11-75
10 Pumping level below land surfaces:
175 ft. after 3 hrs. pumping 15 g.p.m.
____ ft. after ____ hrs. pumping ____ g.p.m.
Estimated maximum yield 50 g.p.m.
11 Water sample submitted:
 Yes No Date ____
12 Well head completion:
 Pitless adapter 12 Inches above grade
13 Well grouted? Yes No
 Neat cement Bentonite
Depth: From 5 ft. to 15 ft.
14 Nearest source of possible contamination:
ft. 700 Direction NW Type Copper L
Well disinfected upon completion? Yes No
15 Pump: Not installed
Manufacturer's name Red Jacket
Model number 11CC HP 1/2 Volts 220
Length of drop pipe 238 ft. capacity 20 g.m.p.
Type:
 Submersible Turbine
 Jet Reciprocating
 Centrifugal Other

16 Remarks: elevation 3709 (TOPO)

Topography:
 Hill
 Slope
 Upland
 Valley

17 Water well contractor's certification:
This well was drilled under my jurisdiction and this report is true to the best of my knowledge and belief.
A & H Drilling Co Jan 1966
Business name _____ License No. _____
Address Goodland Kan
Signed Bill Clifford Date 6-17-75
Authorized representative