USE TYPEWRITER OR BALL POINT PEN-PRESS FIRMLY, PRINT CLEARLY.

WATER WELL RECORD
KSA 82a-1201-1215

AAA

Kansas Department of Health and Environment-Division of Environment
(Water well Contractors)
Topeka, Kansas 66620

1. Location of well:	County	Fraction	Section number	Township number	Range number
	SHERMAN	NE 1/4 NE 1/4 NE 1/4	32	T 8 S	R 39 (E) W

2. Distance and direction from nearest town or city:

Street address of well location if in city:

3. Owner of well: WALKER Briney
R.R. or street: EDSON, KANSAS
City, state, zip code:

4. Locate with "X" in section below:

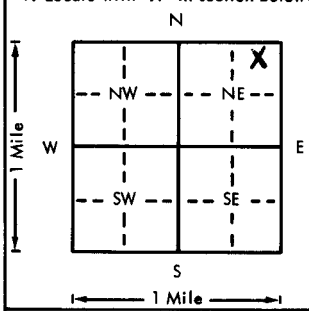

Sketch map:

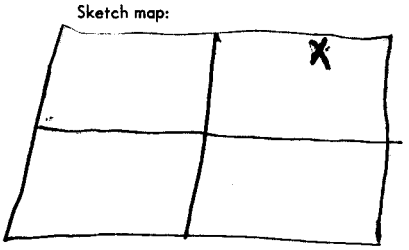

6. Bore hole dia. 26 in. Completion date 12-20-74
Well depth 269 ft.

7. __ Cable tool __ Rotary __ Driven __ Dug
__ Hollow rod __ Jetted __ Bored X Reverse rotary

8. Use: __ Domestic __ Public supply __ Industry
X Irrigation __ Air conditioning __ Stock
__ Lawn __ Oil field water __ Other

9. Casing: Material STEEL Height: (Above) or below
Threaded ___ Welded X Surface 8 in.
RMP ___ PVC ___ Weight 34 lbs./ft.
Dia. 16 in. to 269 ft. depth Wall Thickness: inches or
Dia. ___ in. to ___ ft. depth gage No. .188

5. Type and color of material	From	To
Clay & Gravel	0	147
Sandstone & Clay	147	160
Gravel	160	184
Sand Clay & Sandstone	184	237
Gravel	237	255
Soapestone	255	269
Shale	269	

(Use a second sheet if needed)

10. Screen: Manufacturer's name W. A. Brown
Type Millsolt Dia. 16
Slot gauze 3/8 Length 140
Set between 129 ft. and 269 ft.
___ ft. and ___ ft.
Gravel pack? X Size range of material 3/8 X 1/2

11. Static water level: mo./day/yr.
117 ft. below land surface Date 12-6-74

12. Pumping level below land surfaces:
220 ft. after 1 hrs. pumping 650 g.p.m.
250 ft. after 8 hrs. pumping 790 g.p.m.
Estimated maximum yield 790 g.p.m.

13. Water sample submitted: mo./day/yr.
__ Yes X No Date

14. Well head completion:
__ Pitless adapter ___ Inches above grade

15. Well grouted? Yes
With: X Neat cement __ Bentonite __ Concrete
Depth: From 8" Above ft. to 10 ft.

16. Nearest source of possible contamination:
ft. NONE Direction ___ Type ___
Well disinfected upon completion? ___ Yes X No

17. Pump: Not installed
Manufacturer's name TAIT AYC
Model number GE HP 125 Volts 440
Length of drop pipe 250 ft. capacity 790 g.p.m.
Type:
__ Submersible X Turbine
__ Jet __ Reciprocating
__ Centrifugal __ Other

18. Elevation:

Topography:
__ Hill
X Slope
__ Upland
__ Valley

19. Remarks: 3668 (TOTO)
Concrete Slab was Run By Foust Supply. 8" above Top of Ground.
Ralph Elfman mgr.

20. Water well contractor's certification:
This well was drilled under my jurisdiction and this report is true to the best of my knowledge and belief.
FOUST SUPPLY CO INC 144
Business name License No.
Address Box 338
Signed RALPH ELFMAN Date 10-7-75
Authorized representative

T 8 S R 39 (E) W Sec 32 1/4 NE 1/4 NE 1/4 NE 1/4

Forward the white, blue and pink copies to the Department of Health and Environment

Form WWC-5