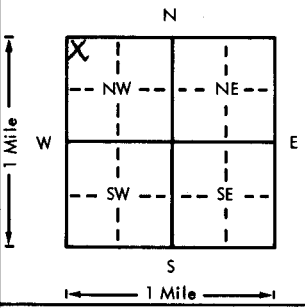


USE TYPEWRITER OR BALL
POINT PEN-PRESS FIRMLY,
PRINT CLEARLY.

WATER WELL RECORD
KSA 82a-1201-1215

Kansas Department of Health and
Environment-Division of Environment
(Water well Contractors)
Topeka, Kansas 66620

1. Location of well:		County	Fraction	Section number	Township number	Range number
		SHERMAN	NW 1/4 NW 1/4 NW 1/4	35	T 8 S	R 39
2. Distance and direction from nearest town or city: Goodland			3. Owner of well: BILL LEITNER			
Street address of well location if in city: 1 S 3 E			R.R. or street: RFD-2			
			City, state, zip code: Goodland Kansas 67235			
4. Locate with "X" in section below:			Sketch map:			6. Bore hole dia. 26 in. Completion date 5-17-76
						Well depth 276 ft.
5. Type and color of material			From	To	7. Cable tool Rotary Driven Dug Hollow rod Jetted Bored X Reverse rotary	
M GRAVEL, Sandy Clay, Sandstone			140	201	8. Use: Domestic Public supply Industry X Irrigation Air conditioning Stock Lawn Oil field water Other	
SANDY CLAY, SANDSTONE			201	215	9. Casing: Material Steel Height: Above or below Threaded Welded X Surface 12 in. RMP PVC Weight 36 lbs./ft.	
HARD SANDSTONE			215	220	Dia. 16 in. to 186 ft. depth Wall Thickness: inches or Dia. in. to ft. depth gage No. 219	
M GRAVEL			220	234	10. Screen: Manufacturer's name Type Louver Dia. 16 Slot/gauze 1/8 x 7 Length 90 Set between 180 ft. and 276 ft.	
M GRAVEL, SANDSTONE			234	239	Gravel pack? YES Size range of material 1/4 x 28	
SANDY CLAY, SANDSTONE			239	251	11. Static water level: mo./day/yr. 147 ft. below land surface Date 5-11-76	
FINE SAND, M GRAVEL			251	264	12. Pumping level below land surfaces: 235 ft. after 7 hrs. pumping 1850 g.p.m. ft. after hrs. pumping g.p.m. Estimated maximum yield 1200 g.p.m.	
Ochre M, GRAVEL			264	272	13. Water sample submitted: mo./day/yr. Yes X No Date	
Ochre			272	276	14. Well head completion: Pitless adapter Inches above grade	
					15. Well grouted? YES With: Neat cement Bentonite X Concrete Depth: From 0 ft. to 10 ft.	
					16. Nearest source of possible contamination: ft. Direction Type None Well disinfected upon completion? Yes X No	
					17. Pump: Not installed Manufacturer's name Western Hard Pallen Model number 8M HP 100 Volts 440 Length of drop pipe 260 ft. capacity 1200 g.p.m. Type: Submersible X Turbine Jet Reciprocating Centrifugal Other	
18. Elevation:			19. Remarks:			20. Water well contractor's certification:
Topography: Hill Slope X Upland Valley			3628 (TOPO)			This well was drilled under my jurisdiction and this report is true to the best of my knowledge and belief. L & H Dillingers Inc. 166 Business name License No. Address Goodland Kansas Signed Bill Dillingers Date 5-17-76 Authorized representative