


1 LOCATION OF WATER WELL: County: **SHERMAN** Fraction: **SW 1/4 NW 1/4 NW 1/4** Section Number: **30** Township Number: **T 8 S** Range Number: **R 39 EW**

Distance and direction from nearest town or city street address of well if located within city?  
**200' N of NW CORNER OF GAS STATION MW-1**

2 WATER WELL OWNER: **Goodland TRAVEL PLAZA TERRY GREEN**  
 RR#, St. Address, Box #: **SE CORNER OF K-27 HWY I-70**  
 City, State, ZIP Code: **GOODLAND, KS 67235**  
 Board of Agriculture, Division of Water Resources  
 Application Number:

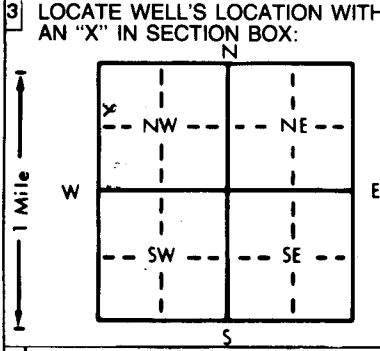

4 DEPTH OF COMPLETED WELL: **202'** ft. ELEVATION: ..... ft.  
 Depth(s) Groundwater Encountered: 1. **180** ft. 2. .... ft. 3. .... ft.  
 WELL'S STATIC WATER LEVEL: **180.20** ft. below land surface measured on mo/day/yr **3/1/95**  
 Pump test data: Well water was ..... ft. after ..... hours pumping ..... gpm  
 Est. Yield ..... gpm: Well water was ..... ft. after ..... hours pumping ..... gpm  
 Bore Hole Diameter: **8.25** in. to **2.10** ft., and ..... in. to ..... ft.  
 WELL WATER TO BE USED AS:  
 1 Domestic 3 Feedlot 6 Oil field water supply 9 Dewatering 12 Other (Specify below)  
 2 Irrigation 4 Industrial 7 Lawn and garden only  Monitoring well  
 Was a chemical/bacteriological sample submitted to Department? Yes.....No..... If yes, mo/day/yr sample was sub-  
 mitted Water Well Disinfected? Yes No

5 TYPE OF BLANK CASING USED:  
 1 Steel 3 RMP (SR) 5 Wrought iron 8 Concrete tile CASING JOINTS: Glued ..... Clamped .....  
 PVC 4 ABS 7 Fiberglass .....  Threaded  
 Blanking diameter: **4"** in. to **172** ft., Dia ..... in. to ..... ft., Dia ..... in. to ..... ft.  
 Casing height above land surface: **0** in., weight ..... lbs./ft. Wall thickness or gauge No. ....  
 TYPE OF SCREEN OR PERFORATION MATERIAL:  
 1 Steel 3 Stainless steel 5 Fiberglass  PVC 10 Asbestos-cement  
 2 Brass 4 Galvanized steel 6 Concrete tile 8 RMP (SR) 11 Other (specify) .....  
 12 None used (open hole)  
 SCREEN OR PERFORATION OPENINGS ARE:  
 1 Continuous slot  Mill slot 5 Gauzed wrapped 8 Saw cut 11 None (open hole)  
 2 Louvered shutter 4 Key punched 6 Wire wrapped 9 Drilled holes  
 7 Torch cut 10 Other (specify) .....  
 SCREEN-PERFORATED INTERVALS: From **202** ft. to **172** ft., From ..... ft. to ..... ft.  
 GRAVEL PACK INTERVALS: From **210** ft. to **170** ft., From ..... ft. to ..... ft.

6 GROUT MATERIAL: 1 Neat cement 2 Cement grout 3 Bentonite 4 Other .....  
 Grout Intervals: From **170** ft. to **168** ft., From **168** ft. to **100** ft., From ..... ft. to ..... ft.  
 What is the nearest source of possible contamination:  
 1 Septic tank 4 Lateral lines 7 Pit privy  Fuel storage 14 Abandoned water well  
 2 Sewer lines 5 Cess pool 8 Sewage lagoon 12 Fertilizer storage 15 Oil well/Gas well  
 3 Watertight sewer lines 6 Seepage pit 9 Feedyard 13 Insecticide storage 16 Other (specify below) .....  
 Direction from well? **PLACED INSIDE SOURCE** How many feet? .....

FROM	TO	LITHOLOGIC LOG	FROM	TO	PLUGGING INTERVALS
0'	30'	SILT, Clay, Dark Brown To Lk Brown, Dry	118'	150'	SAND, FINE TO COARSE, RED BROWN WITH WHITE CALICHE, MOIST
30'	40'	CLAY, SILT, LIGHT BROWN, STIFF MOIST, PETROLEUM ODOR	150'	168'	SAND, MEDIUM TO COARSE, SOME CLAY, BROWN, MOIST,
40'	45'	CLAY, SILT, LT. BROWN, WITH CALICHE STIFF, MOIST, PETROLEUM ODOR	168'	182'	SAND, FINE TO COARSE, GRAY TO LT. BROWN, MOIST
45'	58'	CALICHE, Lt Brown to WHITE, GRADING TO MEDIUM TO COARSE ORANGE CLAYEY SAND, MOIST, PETRO. ODOR	182'	190'	GRAVEL, SAND, COARSE, BROWN WET
58'	68'	GRAVEL, COARSE, BROWN, MOIST	190'	210'	SAND FINE TO MEDIUM, RED BROWN WET
68'	88'	CLAY, SAND, MEDIUM TO COARSE, RED BROWN, STIFF MOIST, PETRO. ODOR			
88'	118'	SAND, FINE TO COARSE, SOME CLAY, BROWN, SOFT, PETRO. ODOR AT 98"			

7 CONTRACTOR'S OR LANDOWNER'S CERTIFICATION: This water well was  constructed, (2) reconstructed, or (3) plugged under my jurisdiction and was completed on (mo/day/year) **2/18/95** and this record is true to the best of my knowledge and belief. Kansas Water Well Contractor's License No. **438** This Water Well Record was completed on (mo/day/yr) **4/20/95** under the business name of **KANSAS CITY TESTING LABS.** by (signature) *[Signature]*