


1 LOCATION OF WATER WELL: Fraction SW 1/4 NW 1/4 NW 1/4 Section Number 30 Township Number T 8 S Range Number R 39 E
 County: SHERMAN

Distance and direction from nearest town or city street address of well if located within city?
250' NNE OF NW CORNER OF GAS STATION MW-2

2 WATER WELL OWNER: GOODLAND TRAVEL PLAZA - TERRY GREEN
 RR#, St. Address, Box #: SE CORNER OF K-27; HWY I-70 Board of Agriculture, Division of Water Resources
 City, State, ZIP Code: GOODLAND, KS 67735 Application Number:

3 LOCATE WELL'S LOCATION WITH AN "X" IN SECTION BOX:

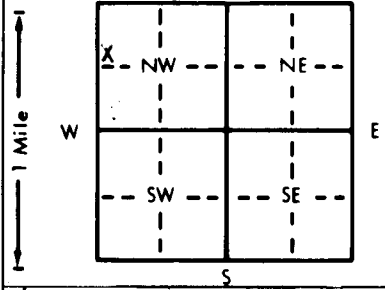

4 DEPTH OF COMPLETED WELL: 202 ft. ELEVATION: ft.
 Depth(s) Groundwater Encountered 1. 180 ft. 2. ft. 3. ft.
 WELL'S STATIC WATER LEVEL 180.06 ft. below land surface measured on mo/day/yr 3/1/95
 Pump test data: Well water was ft. after hours pumping gpm
 Est. Yield gpm: Well water was ft. after hours pumping gpm
 Bore Hole Diameter: 8.25 in. to 2.10 in. and in. to in.
 WELL WATER TO BE USED AS: 5 Public water supply 8 Air conditioning 11 Injection well
 1 Domestic 3 Feedlot 6 Oil field water supply 9 Dewatering 12 Other (Specify below)
 2 Irrigation 4 Industrial 7 Lawn and garden only 10 Monitoring well
 Was a chemical/bacteriological sample submitted to Department? Yes.....No..... If yes, mo/day/yr sample was submitted
 Water Well Disinfected? Yes No

5 TYPE OF BLANK CASING USED: 5 Wrought iron 8 Concrete tile CASING JOINTS: Glued Clamped
 1 Steel 3 RMP (SR) Welded
2 PVC 4 ABS 6 Asbestos-Cement 9 Other (specify below) Threaded
 7 Fiberglass

Blank casing diameter 4 1/2 in. to 172 ft., Dia in. to ft., Dia in. to ft.
 Casing height above land surface 0 in., weight lbs./ft. Wall thickness or gauge No.

TYPE OF SCREEN OR PERFORATION MATERIAL: 7 PVC 10 Asbestos-cement
 1 Steel 3 Stainless steel 5 Fiberglass 8 RMP (SR) 11 Other (specify)
 2 Brass 4 Galvanized steel 6 Concrete tile 9 ABS 12 None used (open hole)

SCREEN OR PERFORATION OPENINGS ARE: 5 Gauzed wrapped 8 Saw cut 11 None (open hole)
 1 Continuous slot 3 Mill slot 6 Wire wrapped 9 Drilled holes
 2 Louvered shutter 4 Key punched 7 Torch cut 10 Other (specify)

SCREEN-PERFORATED INTERVALS: From 202 ft. to 172 ft., From ft. to ft.
 From ft. to ft., From ft. to ft.
 GRAVEL PACK INTERVALS: From 210 ft. to 166 ft., From ft. to ft.
 From ft. to ft., From ft. to ft.

6 GROUT MATERIAL: 1 Neat cement 2 Cement grout 3 Bentonite 4 Other
 Grout Intervals: From 166 ft. to 162 ft., From 162 ft. to 1 ft., From ft. to ft.

What is the nearest source of possible contamination:
 1 Septic tank 4 Lateral lines 7 Pit privy 11 Fuel storage 14 Abandoned water well
 2 Sewer lines 5 Cess pool 8 Sewage lagoon 12 Fertilizer storage 15 Oil well/Gas well
 3 Watertight sewer lines 6 Seepage pit 9 Feedyard 13 Insecticide storage 16 Other (specify below)

Direction from well? SW How many feet? 50'

FROM	TO	LITHOLOGIC LOG	FROM	TO	PLUGGING INTERVALS
0'	0.5'	ASPHALT	118'	158'	SAND, FINE TO COARSE, SOME CLAY, BROWN, SOFT, MOIST
0.5'	36'	SILT, CLAY, LT. BROWN TO LT ORANGE BROWN, DRY TO MOIST	158'	168'	CLAY, SILT, LT. BROWN, SOFT, MOIST
36'	40'	CLAY, SILT AND FINE SAND, LT. BROWN	168'	210'	SAND, FINE TO MEDIUM TRACE GRAVEL BROWN, MOIST
40'	50'	CLAY, WHITE, GRADING TO FINE TO MEDIUM ORANGE BROWN SAND			
50'	68'	SAND FINE TO COARSE, SOME GRAVEL ORANGE BROWN, MOIST			
68'	78'	SAND, MEDIUM TO COARSE, SOME GRAVEL CLAY, BROWN, MOIST, (POR (ALCOHOL))			
78'	88'	GRAVEL, COARSE SAND, BROWN, MOIST			
88'	106'	SAND, FINE TO COARSE, SOME CLAY BROWN, SOFT, MOIST			
106'	118'	GRAVEL, COARSE SAND, BROWN, MOIST			

7 CONTRACTOR'S OR LANDOWNER'S CERTIFICATION: This water well was 1 constructed, (2) reconstructed, or (3) plugged under my jurisdiction and was completed on (mo/day/year) 2-19-95 and this record is true to the best of my knowledge and belief. Kansas Water Well Contractor's License No. 438 This Water Well Record was completed on (mo/day/year)
 under the business name of KANSAS CITY TESTING LABS by (signature) [Signature]

INSTRUCTIONS: Use typewriter or ball point pen. PLEASE PRESS FIRMLY and PRINT clearly. Please fill in blanks, underline or circle the correct answers. Send two copies to Kansas Department of Health and Environment, Bureau of Water, Topeka, Kansas 66620-0001. Telephone: 913-296-5545. Send one to WATER WELL OWNER and retain one for your records.