


1 LOCATION OF WATER WELL: County: SHERMAN Fraction: SW 1/4 NW 1/4 Section Number: 30 Township Number: T 8 S Range Number: R 39 EW

Distance and direction from nearest town or city street address of well if located within city?  
300' N of NE CORNER OF GAS STATION MW-4

2 WATER WELL OWNER: GOODLAND TRAVEL PLAZA - TERRY GREEN  
 RR#, St. Address, Box #: SE CORNER OF K-27 & HWY I-70 Board of Agriculture, Division of Water Resources  
 City, State, ZIP Code: GOODLAND, KS 67735 Application Number:

3 LOCATE WELL'S LOCATION WITH AN "X" IN SECTION BOX:

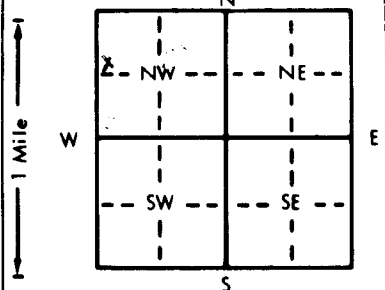

4 DEPTH OF COMPLETED WELL: 195 ft. ELEVATION:

Depth(s) Groundwater Encountered 1. 180 ft. 2. \_\_\_\_\_ ft. 3. \_\_\_\_\_ ft.  
 WELL'S STATIC WATER LEVEL 178.60 ft. below land surface measured on mo/day/yr 3/9/95  
 Pump test data: Well water was \_\_\_\_\_ ft. after \_\_\_\_\_ hours pumping \_\_\_\_\_ gpm  
 Est. Yield \_\_\_\_\_ gpm: Well water was \_\_\_\_\_ ft. after \_\_\_\_\_ hours pumping \_\_\_\_\_ gpm  
 Bore Hole Diameter: 8.25 in. to 210 ft., and \_\_\_\_\_ in. to \_\_\_\_\_ ft.  
 WELL WATER TO BE USED AS: 5 Public water supply 8 Air conditioning 11 Injection well  
 1 Domestic 3 Feedlot 6 Oil field water supply 9 Dewatering 12 Other (Specify below)  
 2 Irrigation 4 Industrial 7 Lawn and garden only 10 Monitoring well  
 Was a chemical/bacteriological sample submitted to Department? Yes \_\_\_\_\_ No ; If yes, mo/day/yr sample was submitted \_\_\_\_\_  
 Water Well Disinfected? Yes \_\_\_\_\_ No

5 TYPE OF BLANK CASING USED: 1 Steel 3 RMP (SR) 5 Wrought iron 8 Concrete tile CASING JOINTS: Glued \_\_\_\_\_ Clamped \_\_\_\_\_  
 PVC 4 ABS 6 Asbestos-Cement 9 Other (specify below) Welded \_\_\_\_\_  
 7 Fiberglass Threaded  
 Blank casing diameter 4 in. to 165 ft., Dia \_\_\_\_\_ in. to \_\_\_\_\_ ft., Dia \_\_\_\_\_ in. to \_\_\_\_\_ ft.  
 Casing height above land surface 0 in., weight \_\_\_\_\_ lbs./ft. Wall thickness or gauge No. \_\_\_\_\_

TYPE OF SCREEN OR PERFORATION MATERIAL:  PVC 10 Asbestos-cement  
 1 Steel 3 Stainless steel 5 Fiberglass 8 RMP (SR) 11 Other (specify) \_\_\_\_\_  
 2 Brass 4 Galvanized steel 6 Concrete tile 9 ABS 12 None used (open hole)

SCREEN OR PERFORATION OPENINGS ARE: 5 Gauzed wrapped 8 Saw cut 11 None (open hole)  
 1 Continuous slot  Mill slot 6 Wire wrapped 9 Drilled holes  
 2 Louvered shutter 4 Key punched 7 Torch cut 10 Other (specify) \_\_\_\_\_

SCREEN-PERFORATED INTERVALS: From 195 ft. to 165 ft. From \_\_\_\_\_ ft. to \_\_\_\_\_ ft.  
 From \_\_\_\_\_ ft. to \_\_\_\_\_ ft. From \_\_\_\_\_ ft. to \_\_\_\_\_ ft.  
 GRAVEL PACK INTERVALS: From 210 ft. to 160 ft. From \_\_\_\_\_ ft. to \_\_\_\_\_ ft.  
 From \_\_\_\_\_ ft. to \_\_\_\_\_ ft. From \_\_\_\_\_ ft. to \_\_\_\_\_ ft.

6 GROUT MATERIAL: 1 Neat cement 2 Cement grout  Bentonite 4 Other \_\_\_\_\_  
 Grout Intervals: From 160 ft. to 158 ft., From 158 ft. to 1 ft. From \_\_\_\_\_ ft. to \_\_\_\_\_ ft.

What is the nearest source of possible contamination:  
 1 Septic tank 4 Lateral lines 7 Pit privy  Fuel storage 10 Livestock pens 14 Abandoned water well  
 2 Sewer lines 5 Cess pool 8 Sewage lagoon 12 Fertilizer storage 15 Oil well/Gas well  
 3 Watertight sewer lines 6 Seepage pit 9 Feedyard 13 Insecticide storage 16 Other (specify below)

Direction from well? W How many feet? 140

FROM	TO	LITHOLOGIC LOG	FROM	TO	PLUGGING INTERVALS
0'	3'	Fill, CLAYEY SAND w/ GRAVEL, BROWN	138'	158'	SANDY LEAN CLAY, WITH CALCITE
3'	29.5'	LT. BROWN, CLAYEY SAND, SILT	158'	168'	SAND MEDIUM TO COARSE GRAIN
29.5'	34.5'	BROWN, SILT			WITH LENSES OF SILTY CLAY
34.5'	39.5'	SILTY CLAY, TRACE CALCICHE, MOIST, BROWN	168'	210'	SILTY SAND, FINE TO COARSE GRAIN, BROWN, MOIST TO WET
39.5'	41'	BROWN, SILTY CLAY			
41'	49.5'	CALICHE, FINE TO MEDIUM GRAIN, LAYERS OF ORANGE CALICHE			
49.5'	53'	SAND FINE TO MEDIUM GRAIN, LT. BROWN			
53'	78'	SAND FINE TO COARSE, WITH GRAVEL RED/ORANGE CEMENTED CALCITE			
78'	118'	SAND FINE TO COARSE, BROWN, MOIST			
118'	128'	CALICHE w/ QUARTZ, ORANGE			
128'	138'	SAND, FINE GRAIN, BROWN			

7 CONTRACTOR'S OR LANDOWNER'S CERTIFICATION: This water well was  constructed, (2) reconstructed, or (3) plugged under my jurisdiction and was completed on (mo/day/year) 3/5/95 and this record is true to the best of my knowledge and belief. Kansas Water Well Contractor's License No. 438 This Water Well Record was completed on (mo/day/yr) 4/9/97 under the business name of KANSAS CITY TESTING LABS by (signature) [Signature]