

1 LOCATION OF WATER WELL:	Fraction	Section Number	Township Number	Range Number
County: <u>SHERMAN</u>	<u>SW 1/4 NW 1/4 NW 1/4</u>	<u>30</u>	T <u>8</u> S	R <u>39</u> <u>EW</u>

Distance and direction from nearest town or city street address of well if located within city?

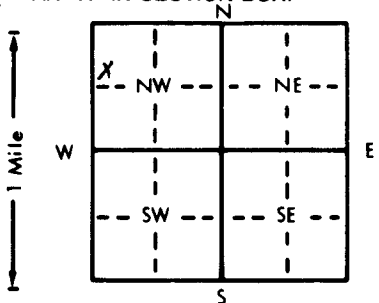
315' NNW OF NW CORNER OF GAS STATION MW-62 WATER WELL OWNER: GOODLAND TRAVEL PLAZA - TERRY GREENRR#, St. Address, Box # : SE CORNER OF K-27; HWY I-70

Board of Agriculture, Division of Water Resources

City, State, ZIP Code : GOODLAND, KS 67735

Application Number:

3 LOCATE WELL'S LOCATION WITH AN "X" IN SECTION BOX:

4 DEPTH OF COMPLETED WELL. 190 ft. ELEVATION:Depth(s) Groundwater Encountered 1. 180 ft. 2. ft. 3. ft.WELL'S STATIC WATER LEVEL 188.04 ft. below land surface measured on mo/day/yr 3/28/95

Pump test data: Well water was ft. after hours pumping gpm

Est. Yield gpm: Well water was ft. after hours pumping gpm

Bore Hole Diameter 8.25 in. to 210 ft., and in. to ft.

WELL WATER TO BE USED AS: 5 Public water supply 8 Air conditioning 11 Injection well

1 Domestic 3 Feedlot 6 Oil field water supply 9 Dewatering 12 Other (Specify below)

2 Irrigation 4 Industrial 7 Lawn and garden only 10 Monitoring well

Was a chemical/bacteriological sample submitted to Department? Yes No ☒ If yes, mo/day/yr sample was submittedWater Well Disinfected? Yes No ☒

5 TYPE OF BLANK CASING USED:

1 Steel 3 RMP (SR)

6 PVC 4 ABS

5 Wrought iron

8 Concrete tile

CASING JOINTS: Glued Clamped

6 Asbestos-Cement

9 Other (specify below)

Welded

7 Fiberglass

Threaded

Blank casing diameter 4" in. to 160 ft., Dia in. to ft., Dia in. to ft.

Casing height above land surface in. weight lbs./ft. Wall thickness or gauge No.

TYPE OF SCREEN OR PERFORATION MATERIAL:

1 Steel 3 Stainless steel

5 Fiberglass

7 PVC

10 Asbestos-cement

2 Brass 4 Galvanized steel

6 Concrete tile

8 RMP (SR)

11 Other (specify)

12 None used (open hole)

SCREEN OR PERFORATION OPENINGS ARE:

1 Continuous slot 3 Mill slot

5 Gauzed wrapped

8 Saw cut

11 None (open hole)

2 Louvered shutter 4 Key punched

6 Wire wrapped

9 Drilled holes

7 Torch cut

10 Other (specify)

SCREEN-PERFORATED INTERVALS: From 190 ft. to 160 ft., From ft. to ft.

From ft. to ft., From ft. to ft.

GRAVEL PACK INTERVALS: From 210 ft. to 155 ft., From ft. to ft.

From ft. to ft., From ft. to ft.

6 GROUT MATERIAL:

1 Neat cement

2 Cement grout

3 Bentonite

4 Other

Grout intervals: From 155 ft. to 153 ft., From 153 ft. to 1 ft., From ft. to ft.

What is the nearest source of possible contamination:

1 Septic tank 4 Lateral lines

7 Pit privy

10 Livestock pens

14 Abandoned water well

2 Sewer lines 5 Cess pool

8 Sewage lagoon

11 Fuel storage

15 Oil well/Gas well

3 Watertight sewer lines 6 Seepage pit

9 Feedyard

12 Fertilizer storage

16 Other (specify below)

13 Insecticide storage

Direction from well? SHow many feet? 140'

FROM	TO	LITHOLOGIC LOG	FROM	TO	PLUGGING INTERVALS
0'	2'	FILL, SILTY, SAND, BROWN, SOME GRAVEL			
2'	3'	SANDY, LEAN, CLAY, WITH GRAVEL, BROWN			
3'	33'	SILT, LT. BROWN, SL. MOIST			
33'	36'	SANDY, LEAN, CLAY, BROWN			
36'	49.5'	CALICHE, ORANGE, WHITE, TAN, STIFF, DRY			
49.5'	78'	SAND, FINE TO MEDIUM, LT. BROWN, DRY			
78'	118'	SAND, FINE TO COARSE, BROWN, SOME GRAVEL			
118'	128'	CALICHE, ORANGE, WHITE, DRY			
128'	138'	SAND, MEDIUM TO COARSE GRAIN, BROWN			
138'	158'	SILTY, SAND, FIRM, FINE GRAIN, LT. BROWN WITH SOME GRAVEL			
158'	178'	SAND, FINE TO MEDIUM GRAIN, LT. BROWN			
178'	183'	CALICHE, LT. BROWN			
183'	210'	SAND, FINE GRAIN, A LITTLE GRAVEL			

7 CONTRACTOR'S OR LANDOWNER'S CERTIFICATION: This water well was (1) constructed, (2) reconstructed, or (3) plugged under my jurisdiction and was completed on (mo/day/year) 3/27/95 and this record is true to the best of my knowledge and belief. KansasWater Well Contractor's License No. 438 This Water Well Record was completed on (mo/day/yr) 4-25-95under the business name of KANSAS CITY TESTING LABS by (signature) [Signature]

INSTRUCTIONS: Use typewriter or ball point pen. PLEASE PRESS FIRMLY and PRINT clearly. Please fill in blanks, underline or circle the correct answers. Send top three copies to Kansas Department of Health and Environment, Bureau of Water, Topeka, Kansas 66620-0001. Telephone: 913-296-5545. Send one to WATER WELL OWNER and retain one for your records.