


1 LOCATION OF WATER WELL: Fraction SW 1/4 NW 1/4 NW 1/4 Section Number 30 Township Number T 8 S Range Number R 39 E
 County: SHERMAN

Distance and direction from nearest town or city street address of well if located within city?
1/16' NNE of NW CORNER OF GAS STATION MW - 7

2 WATER WELL OWNER: GOODLAND TRAVEL PLAZA - TERRY GREEN
 RR#, St. Address, Box #: SE CORNER OF K-27 HWY I-70 Board of Agriculture, Division of Water Resources
 City, State, ZIP Code: GOODLAND, KS 67735 Application Number:

3 LOCATE WELL'S LOCATION WITH AN "X" IN SECTION BOX:

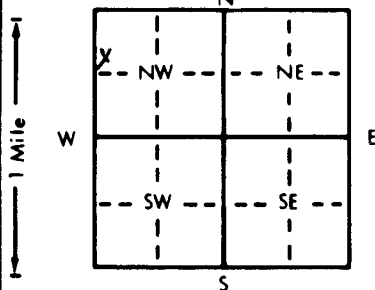

4 DEPTH OF COMPLETED WELL: 195 ft. ELEVATION:

Depth(s) Groundwater Encountered 1. 180 ft. 2. _____ ft. 3. _____ ft.
 WELL'S STATIC WATER LEVEL 178.44 ft. below land surface measured on mo/day/yr 3/28/95
 Pump test data: Well water was _____ ft. after _____ hours pumping _____ gpm
 Est. Yield _____ gpm: Well water was _____ ft. after _____ hours pumping _____ gpm
 Bore Hole Diameter: 8.25 in. to 210 in. to _____ in. to _____ in.
 WELL WATER TO BE USED AS: 5 Public water supply 8 Air conditioning 11 Injection well
 1 Domestic 3 Feedlot 6 Oil field water supply 9 Dewatering 12 Other (Specify below)
 2 Irrigation 4 Industrial 7 Lawn and garden only 10 Monitoring well
 Was a chemical/bacteriological sample submitted to Department? Yes _____ No ✓; If yes, mo/day/yr sample was submitted _____
 Water Well Disinfected? Yes _____ No ✓

5 TYPE OF BLANK CASING USED: 1 Steel 3 RMP (SR) 5 Wrought iron 8 Concrete tile CASING JOINTS: Glued _____ Clamped _____
2 PVC 4 ABS 6 Asbestos-Cement 9 Other (specify below) Welded _____
 7 Fiberglass Threaded

Blank casing diameter 4" in. to 165 ft., Dia _____ in. to _____ ft., Dia _____ in. to _____ ft.
 Casing height above land surface 0 in., weight _____ lbs./ft. Wall thickness or gauge No. _____

TYPE OF SCREEN OR PERFORATION MATERIAL: 7 PVC 10 Asbestos-cement
 1 Steel 3 Stainless steel 5 Fiberglass 8 RMP (SR) 11 Other (specify) _____
 2 Brass 4 Galvanized steel 6 Concrete tile 9 ABS 12 None used (open hole)

SCREEN OR PERFORATION OPENINGS ARE: 5 Gauzed wrapped 8 Saw cut 11 None (open hole)
 1 Continuous slot 3 Mill slot 6 Wire wrapped 9 Drilled holes
 2 Louvered shutter 4 Key punched 7 Torch cut 10 Other (specify) _____

SCREEN-PERFORATED INTERVALS: From 195 ft. to 165 ft., From _____ ft. to _____ ft.
 From _____ ft. to _____ ft., From _____ ft. to _____ ft.
 GRAVEL PACK INTERVALS: From 210 ft. to 150 ft., From _____ ft. to _____ ft.
 From _____ ft. to _____ ft., From _____ ft. to _____ ft.

6 GROUT MATERIAL: 1 Neat cement 2 Cement grout 3 Bentonite 4 Other _____
 Grout Intervals: From 160 ft. to 158 ft., From 158 ft. to 1 ft., From _____ ft. to _____ ft.

What is the nearest source of possible contamination: 10 Livestock pens 14 Abandoned water well
 1 Septic tank 4 Lateral lines 7 Pit privy 1 Fuel storage 15 Oil well/Gas well
 2 Sewer lines 5 Cess pool 8 Sewage lagoon 12 Fertilizer storage 16 Other (specify below)
 3 Watertight sewer lines 6 Seepage pit 9 Feedyard 13 Insecticide storage

Direction from well? NW How many feet? 140'

FROM	TO	LITHOLOGIC LOG	FROM	TO	PLUGGING INTERVALS
0'	0.5'	ASPHALT	128'	168'	SAND, FINE TO MEDIUM GRAIN, LT. BROWN
.5'	3'	FILL, SAND, BROWN, SOME GRAVEL			SOME CALICHE
3'	4.5'	SANDY, LEAN, CLAY, BROWN	168'	178'	SILT, LT. BROWN, SOME GRAVEL
4.5'	39.5'	LT. BROWN, SILT, DRY	178'	210'	SAND, MEDIUM TO COARSE GRAIN, LT. BROWN, MOIST TO WET.
39.5'	44.5'	BROWN SILT, WITH LAMINATIONS OF CALICHE, DRY			
44.5'	58.5'	CALICHE, WHITE TO ORANGE WITH SOME FINE TO MEDIUM SAND, DRY			
58.5'	64'	SILTY, SAND, MEDIUM TO COARSE GRAIN LT. BROWN, DRY			
64'	88'	SAND, FINE TO COARSE, LT. BROWN, DRY			
88'	118'	SAND, FINE TO MEDIUM, LT. BROWN, DRY			
118'	128'	SAND, FINE GRAIN, WITH SOME CALICHE REDISH - BROWN			

7 CONTRACTOR'S OR LANDOWNER'S CERTIFICATION: This water well was 1 constructed, (2) reconstructed, or (3) plugged under my jurisdiction and was completed on (mo/day/year) 3/21/95 and this record is true to the best of my knowledge and belief. Kansas Water Well Contractor's License No. 438 This Water Well Record was completed on (mo/day/yr) 3-25-95 under the business name of KANSAS CITY TESTING LABS by (signature) [Signature]