


1 LOCATION OF WATER WELL: Fraction SW 1/4 NW 1/4 NW 1/4 Section Number 30 Township Number T 8 S Range Number R 39 EW  
 County: SHERMAN

Distance and direction from nearest town or city street address of well if located within city?  
150' NW OF NW CORNER OF GAS STATION MW-8

2 WATER WELL OWNER: GOODLAND TRAVEL PLAZA - TERRY GREEN  
 RR#, St. Address, Box #: SE CORNER OF K-27 HWY I-70 Board of Agriculture, Division of Water Resources  
 City, State, ZIP Code: GOODLAND, KS 67735 Application Number:

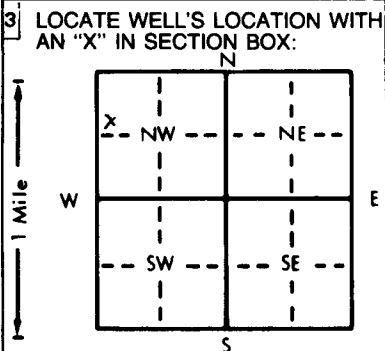

4 DEPTH OF COMPLETED WELL: 200 ft. ELEVATION:  
 Depth(s) Groundwater Encountered 1. 180' ft. 2. \_\_\_\_\_ ft. 3. \_\_\_\_\_ ft.  
 WELL'S STATIC WATER LEVEL 178.67 ft. below land surface measured on mo/day/yr 4-22-95  
 Pump test data: Well water was \_\_\_\_\_ ft. after \_\_\_\_\_ hours pumping \_\_\_\_\_ gpm  
 Est. Yield \_\_\_\_\_ gpm: Well water was \_\_\_\_\_ ft. after \_\_\_\_\_ hours pumping \_\_\_\_\_ gpm  
 Bore Hole Diameter 8.25 in. to 2.10 in. to \_\_\_\_\_ in. to \_\_\_\_\_ in. to \_\_\_\_\_ in. to \_\_\_\_\_ in.  
 WELL WATER TO BE USED AS: 5 Public water supply 8 Air conditioning 11 Injection well  
 1 Domestic 3 Feedlot 6 Oil field water supply 9 Dewatering 12 Other (Specify below)  
 2 Irrigation 4 Industrial 7 Lawn and garden only 10 Monitoring well  
 Was a chemical/bacteriological sample submitted to Department? Yes \_\_\_\_\_ No ✓; If yes, mo/day/yr sample was submitted \_\_\_\_\_  
 Water Well Disinfected? Yes \_\_\_\_\_ No ✓

5 TYPE OF BLANK CASING USED: 5 Wrought iron 8 Concrete tile CASING JOINTS: Glued \_\_\_\_\_ Clamped \_\_\_\_\_  
 1 Steel 3 RMP (SR) 6 Asbestos-Cement 9 Other (specify below) Welded \_\_\_\_\_  
2 PVC 4 ABS 7 Fiberglass Threaded  
 Blank casing diameter 4" in. to 170 ft. Dia \_\_\_\_\_ in. to \_\_\_\_\_ ft.  
 Casing height above land surface 0 in. weight \_\_\_\_\_ lbs./ft. Wall thickness or gauge No. \_\_\_\_\_  
 TYPE OF SCREEN OR PERFORATION MATERIAL: 7 PVC 10 Asbestos-cement  
 1 Steel 3 Stainless steel 5 Fiberglass 8 RMP (SR) 11 Other (specify) \_\_\_\_\_  
 2 Brass 4 Galvanized steel 6 Concrete tile 9 ABS 12 None used (open hole)  
 SCREEN OR PERFORATION OPENINGS ARE: 5 Gauzed wrapped 8 Saw cut 11 None (open hole)  
 1 Continuous slot 3 Mill slot 6 Wire wrapped 9 Drilled holes  
 2 Louvered shutter 4 Key punched 7 Torch cut 10 Other (specify) \_\_\_\_\_  
 SCREEN-PERFORATED INTERVALS: From 200 ft. to 170 ft. From \_\_\_\_\_ ft. to \_\_\_\_\_ ft. From \_\_\_\_\_ ft. to \_\_\_\_\_ ft. From \_\_\_\_\_ ft. to \_\_\_\_\_ ft.  
 GRAVEL PACK INTERVALS: From 210 ft. to 165 ft. From \_\_\_\_\_ ft. to \_\_\_\_\_ ft. From \_\_\_\_\_ ft. to \_\_\_\_\_ ft. From \_\_\_\_\_ ft. to \_\_\_\_\_ ft.

6 GROUT MATERIAL: 1 Neat cement 2 Cement grout 3 Bentonite 4 Other \_\_\_\_\_  
 Grout Intervals: From 165 ft. to 163 ft., From 163 ft. to 1 ft. From \_\_\_\_\_ ft. to \_\_\_\_\_ ft. From \_\_\_\_\_ ft. to \_\_\_\_\_ ft.  
 What is the nearest source of possible contamination:  
 1 Septic tank 4 Lateral lines 7 Pit privy 11 Fuel storage 14 Abandoned water well  
 2 Sewer lines 5 Cess pool 8 Sewage lagoon 12 Fertilizer storage 15 Oil well/Gas well  
 3 Watertight sewer lines 6 Seepage pit 9 Feedyard 13 Insecticide storage 16 Other (specify below) \_\_\_\_\_  
 Direction from well? NW How many feet? 70

FROM	TO	LITHOLOGIC LOG	FROM	TO	PLUGGING INTERVALS
0'	0.5'	ASPHALT	140'	210'	SILTY, SAND, FINE TO MEDIUM GRAIN, BROWN, NO ODOR
0.5'	3'	SILTY, SAND, DARK BROWN, GRAVEL			
3'	5'	SANDY, SILT, DARK BROWN, NO ODOR, DRY			
5'	32'	BROWN SILT, CLAY, DRY, NO ODOR, SL. STIFF			
32'	42'	LT. BROWN SILTY CLAY, NO ODOR, STIFF, DRY			
42'	52'	LT. BROWN, SILTY, SANDY, CLAY, VERY STIFF, DRY, NO ODOR			
52'	58'	LT. BROWN, SANDY, SILTY, CLAY, STIFF, NO ODOR			
58'	80'	BROWN, SILTY, SAND, FINE TO COARSE GRAIN, NO ODOR			
80'	120'	BROWN SILTY, SAND, FINE TO COARSE, NO ODOR			
120'	140'	SILTY, CLAY, SAND, BROWN, NO ODOR, STIFF			

7 CONTRACTOR'S OR LANDOWNER'S CERTIFICATION: This water well was 1 constructed, (2) reconstructed, or (3) plugged under my jurisdiction and was completed on (mo/day/year) 4/22/95 and this record is true to the best of my knowledge and belief. Kansas Water Well Contractor's License No. 438 This Water Well Record was completed on (mo/day/yr) 4-25-95 under the business name of KANSAS CITY TESTING LABS by (signature) [Signature]