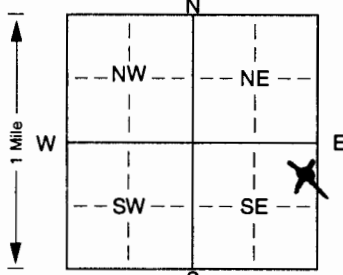


1 LOCATION OF WATER WELL: Fraction **NE 1/4 NE 1/4 SE 1/4** Section Number **26** Township Number **T 8 S** Range Number **R 4 EW**
 County: **Cloud**

Distance and direction from nearest town or city street address of well if located within city? **OF Delphos 4 miles North + 1 mi East**

2 WATER WELL OWNER: **Bob Smith**
 RR#, St. Address, Box # : **Rt. 1** Board of Agriculture, Division of Water Resources
 City, State, ZIP Code : **Delphos, KS 67436** Application Number:

3 LOCATE WELL'S LOCATION WITH AN "X" IN SECTION BOX:  4 DEPTH OF COMPLETED WELL: **60** ft. ELEVATION: ft.
 Depth(s) Groundwater Encountered 1. ft. 2. ft. 3. ft.
 WELL'S STATIC WATER LEVEL: **12** ft. below land surface measured on **8/6/01**
 Pump test data: Well water was ft. after hours pumping gpm
 Est. Yield **20-30** gpm: Well water was ft. after hours pumping gpm
 Bore Hole Diameter: **9** in. to **60** ft., and in. to ft.
 WELL WATER TO BE USED AS: 5 Public water supply 8 Air conditioning 11 Injection well
 1 Domestic 3 Feedlot 6 Oil field water supply 9 Dewatering 12 Other (Specify below)
 2 Irrigation 4 Industrial 7 Domestic (lawn & garden) 10 Monitoring well **Stock well (Dog Kennel)**
 Was a chemical/bacteriological sample submitted to Department? Yes. No. **X**; If yes, mo/day/yr sample was submitted Water Well Disinfected? Yes **X** No

5 TYPE OF BLANK CASING USED: 5 Wrought iron 8 Concrete tile CASING JOINTS: Glued. **X** Clamped.
 1 Steel 3 RMP (SR) 6 Asbestos-Cement 9 Other (specify below) Welded
~~2 PVC~~ 4 ABS 7 Fiberglass Threaded.
 Blank casing diameter: **5** in. to **50** ft., Dia in. to ft., Dia in. to ft.
 Casing height above land surface: **12** in., weight **2.37** lbs./ft. Wall thickness or gauge No. **214**
 TYPE OF SCREEN OR PERFORATION MATERIAL: ~~7 PVC~~ 10 Asbestos-cement
 1 Steel 3 Stainless steel 5 Fiberglass 8 RMP (SR) 11 Other (specify)
 2 Brass 4 Galvanized steel 6 Concrete tile 9 ABS 12 None used (open hole)
 SCREEN OR PERFORATION OPENINGS ARE: 5 Gauzed wrapped 8 Saw cut 11 None (open hole)
 1 Continuous slot **3 Mill slot** 6 Wire wrapped 9 Drilled holes
 2 Louvered shutter 4 Key punched 7 Torch cut 10 Other (specify) ft.
 SCREEN-PERFORATED INTERVALS: From **50** ft. to **60** ft., From ft. to ft.
 From ft. to ft., From ft. to ft.
 GRAVEL PACK INTERVALS: From **25** ft. to **60** ft., From ft. to ft.
 From ft. to ft., From ft. to ft.

6 GROUT MATERIAL: 1 Neat cement 2 Cement grout **3 Bentonite** 4 Other
 Grout Intervals: From **2** ft. to **25** ft., From ft. to ft., From ft. to ft.
 What is the nearest source of possible contamination:
 1 Septic tank 4 Lateral lines 7 Pit privy 10 Livestock pens 14 Abandoned water well
 2 Sewer lines 5 Cess pool 8 Sewage lagoon 11 Fuel storage 15 Oil well/Gas well
 3 Watertight sewer lines 6 Seepage pit 9 Feedyard 12 Fertilizer storage 16 Other (specify below)
 13 Insecticide storage **Dog Kennel**
 Direction from well? **North** *APPROVED By County* How many feet? **35**

FROM	TO	LITHOLOGIC LOG	FROM	TO	PLUGGING INTERVALS
0	2	Topsoil			
2	9	Clay, tan			
9	30	Clay, tan, sandy			
30	34	Sandrock			
34	60	Sandstone			

7 CONTRACTOR'S OR LANDOWNER'S CERTIFICATION: This water well was **reconstructed**, (2) reconstructed, or (3) plugged under my jurisdiction and was completed on (mo/day/year) **8/6/01** and this record is true to the best of my knowledge and belief. Kansas Water Well Contractor's Licence No. **138** This Water Well Record was completed on (mo/day/yr) **8/8/01** under the business name of **Peterson Irrigation, Inc.** by (signature) *Mike Peterson*