WATER WELL RECORD Form WWC-5 KSA 82a-1212

1 LOCATION OF WATER WELL: County: SHERMAN | Fraction: NE ¼ SE ¼ SE ¼ | Section Number: 9 | Township Number: T 8 (S) | Range Number: R 40 (E) W

Distance and direction from nearest town or city street address of well if located within city? 2W 2N Goodland KS.

2 WATER WELL OWNER: SHORT + SON
RR#, St. Address, Box # : Hwy 24 / Box 695
City, State, ZIP Code : Goodland, KS 67735
Board of Agriculture, Division of Water Resources
Application Number:

3 LOCATE WELL'S LOCATION WITH AN "X" IN SECTION BOX:

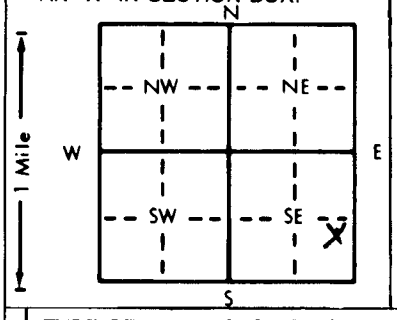

4 DEPTH OF COMPLETED WELL 220 ft. ELEVATION:
Depth(s) Groundwater Encountered 1. 95 ft. 2. ft. 3. ft.
WELL'S STATIC WATER LEVEL 95 ft. below land surface measured on mo/day/yr 6-13-95
Pump test data: Well water was ft. after hours pumping gpm
Est. Yield 15 gpm: Well water was ft. after hours pumping gpm
Bore Hole Diameter 8 in. to 220 ft., and in. to ft.
WELL WATER TO BE USED AS: 1 Domestic 2 Irrigation 3 Feedlot 4 Industrial 5 Public water supply 6 Oil field water supply 7 Lawn and garden only 8 Air conditioning 9 Dewatering 10 Monitoring well 11 Injection well 12 Other (Specify below)
Was a chemical/bacteriological sample submitted to Department? Yes (No); If yes, mo/day/yr sample was submitted
Water Well Disinfected? (Yes) No

5 TYPE OF BLANK CASING USED: 1 Steel (2 PVC) 3 RMP (SR) 4 ABS 5 Wrought iron 6 Asbestos-Cement 7 Fiberglass 8 Concrete tile 9 Other (specify below)
CASING JOINTS: Glued X Clamped Welded Threaded
Blank casing diameter 4.5" in. to ft., Dia in. to ft., Dia in. to ft.
Casing height above land surface 12" in., weight 160# lbs./ft. Wall thickness or gauge No. SDR 26

TYPE OF SCREEN OR PERFORATION MATERIAL: (7 PVC)
1 Steel 2 Brass 3 Stainless steel 4 Galvanized steel 5 Fiberglass 6 Concrete tile 8 RMP (SR) 9 ABS 10 Asbestos-cement 11 Other (specify) 12 None used (open hole)

SCREEN OR PERFORATION OPENINGS ARE: 1 Continuous slot 2 Louvered shutter 3 Mill slot 4 Key punched 5 Gauzed wrapped 6 Wire wrapped 7 Torch cut (8 Saw cut) 9 Drilled holes 10 Other (specify) 11 None (open hole)

SCREEN-PERFORATED INTERVALS: From 200-220 ft. to ft., From ft. to ft.
Cuttings From 95-180 ft. to ft., From ft. to ft.
GRAVEL PACK INTERVALS: From 180-220 ft. to ft., From ft. to ft.
Sand From 20-95 ft. to ft., From ft. to ft.

6 GROUT MATERIAL: (1 Neat cement) 2 Cement grout 3 Bentonite 4 Other
Grout Intervals: From 0 ft. to 20 ft., From ft. to ft., From ft. to ft.

What is the nearest source of possible contamination:
1 Septic tank 2 Sewer lines 3 Watertight sewer lines 4 Lateral lines 5 Cess pool 6 Seepage pit 7 Pit privy 8 Sewage lagoon 9 Feedyard 10 Livestock pens 11 Fuel storage 12 Fertilizer storage 13 Insecticide storage 14 Abandoned water well 15 Oil well/Gas well 16 Other (specify below)
Direction from well? NONE IN VIEW How many feet?

FROM	TO	LITHOLOGIC LOG	FROM	TO	PLUGGING INTERVALS
0	40	clay			
40	100	sand and clay			
100	200	sand and clay			
200	220	Med. clean sand			

7 CONTRACTOR'S OR LANDOWNER'S CERTIFICATION: This water well was (1) (constructed) (2) reconstructed, or (3) plugged under my jurisdiction and was completed on (mo/day/year) 6-13-95 and this record is true to the best of my knowledge and belief. Kansas Water Well Contractor's License No. 484 This Water Well Record was completed on (mo/day/yr) 6-13-95 under the business name of Schaal Drilling Co by (signature) Richard Schaal

INSTRUCTIONS: Use typewriter or ball point pen. PLEASE PRESS FIRMLY and PRINT clearly. Please fill in blanks, underline or circle the correct answers. Send top three copies to Kansas Department of Health and Environment, Bureau of Water, Topeka, Kansas 66620-0001. Telephone: 913-296-5545. Send one to WATER WELL OWNER and retain one for your records.