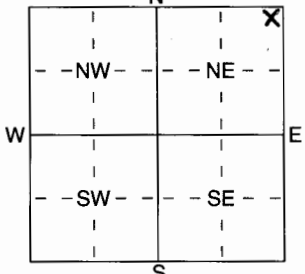


1 LOCATION OF WATER WELL: Fraction Section Number Township Number Range Number  
 County: SHERMAN NE 1/4 NE 1/4 NE 1/4 11 T 8 S R 40 EW

Distance and direction from nearest town or city street address of well if located within city?

2N - 1W OF GOODLAND

2 WATER WELL OWNER: DAVID DORN  
 RR#, St. Address, Box # : 6690 RD 18  
 City, State, ZIP Code : GOODLAND, KS 67735  
 Board of Agriculture, Division of Water Resources  
 Application Number:

3 LOCATE WELL'S LOCATION WITH AN "X" IN SECTION BOX:  
  
 4 DEPTH OF COMPLETED WELL 280 ft. ELEVATION: .....  
 Depth(s) Groundwater Encountered 198 ft. 2 ..... ft. 3 ..... ft.  
 WELL'S STATIC WATER LEVEL 198 ft. below land surface measured on mo/day/yr 11-1-06  
 Pump test data: Well water was ..... ft. after ..... hours pumping ..... gpm  
 Est. Yield 15 gpm: Well water was ..... ft. after ..... hours pumping ..... gpm  
 WELL WATER TO BE USED AS:  
 1 Domestic 3 Feedlot 5 Public water supply 8 Air conditioning 11 Injection well  
 2 Irrigation 4 Industrial 6 Oil field water supply 9 Dewatering 12 Other (Specify below)  
 7 Domestic (lawn & garden) 10 Monitoring well .....  
 Was a chemical/bacteriological sample submitted to Department? Yes ..... No X; If yes, mo/day/yr sample was submitted  
 Water Well Disinfected? Yes No

5 TYPE OF BLANK CASING USED:  
 1 Steel 3 RMP (SR) 5 Wrought iron 8 Concrete tile CASING JOINTS: Glued ..... Clamped .....  
2 PVC 4 ABS 6 Asbestos-Cement 9 Other (specify below) Welded .....  
 7 Fiberglass ..... Threaded .....  
 Blank casing diameter 5 in. to 240 ft. Dia ..... in. to ..... ft. Dia ..... in. to ..... ft.  
 Casing height above land surface 12" in., weight 2.05 lbs./ft. Wall thickness or gauge No. SDR 21  
 TYPE OF SCREEN OR PERFORATION MATERIAL:  
 1 Steel 3 Stainless Steel 5 Fiberglass 7 PVC 10 Asbestos-Cement  
 2 Brass 4 Galvanized Steel 6 Concrete tile 8 RMP (SR) 11 Other (Specify) .....  
 9 ABS 12 None used (open hole)  
 SCREEN OR PERFORATION OPENINGS ARE:  
 1 Continuous slot 3 Mill slot 5 Gauzed wrapped 8 Saw cut 11 None (open hole)  
 2 Louvered shutter 4 Key punched 6 Wire wrapped 9 Drilled holes  
 7 Torch cut 10 Other (specify) ..... ft.  
 SCREEN-PERFORATED INTERVALS: From 140 ft. to 280 ft., From ..... ft. to ..... ft.  
 GRAVEL PACK INTERVALS: From ..... ft. to ..... ft., From ..... ft. to ..... ft.  
PEA GRAVEL From 20 ft. to 280 ft., From ..... ft. to ..... ft.

6 GROUT MATERIAL: 1 Neat cement 2 Cement grout 3 Bentonite 4 Other .....  
 Grout Intervals: From 0 ft. to 20 ft., From ..... ft. to ..... ft., From ..... ft. to ..... ft.  
 What is the nearest source of possible contamination:  
 1 Septic tank 4 Lateral lines 7 Pit privy 10 Livestock pens 14 Abandoned water well  
 2 Sewer lines 5 Cess pool 8 Sewage lagoon 11 Fuel storage 15 Oil well/Gas well  
 3 Watertight sewer lines 6 Seepage pit 9 Feedyard 12 Fertilizer storage 16 Other (specify below)  
 13 Insecticide storage .....  
 Direction from well? NONE IN VIEW How many feet?

FROM	TO	LITHOLOGIC LOG	FROM	TO	PLUGGING INTERVALS
<u>0</u>	<u>20</u>	<u>CLAY</u>			
<u>20</u>	<u>40</u>	<u>CLAY</u>			
<u>40</u>	<u>160</u>	<u>GRAVEL-CLAY</u>			
<u>160</u>	<u>180</u>	<u>CLAY</u>			
<u>180</u>	<u>200</u>	<u>GRAVEL-CLAY</u>			
<u>200</u>	<u>220</u>	<u>STONE-CLAY</u>			
<u>220</u>	<u>240</u>	<u>STONE-SAND</u>			
<u>240</u>	<u>260</u>	<u>SAND-CLAY</u>			
<u>260</u>	<u>280</u>	<u>SHALE-SAND-CLAY</u>			

7 CONTRACTOR'S OR LANDOWNER'S CERTIFICATION: This water well was (1) constructed, (2) reconstructed, or (3) plugged under my jurisdiction and was completed on (mo/day/year) 11-1-06 and this record is true to the best of my knowledge and belief. Kansas Water Well Contractor's Licence No 484 This Water Well Record was completed on (mo/day/yr) 12-8-06 under the business name of SCHAAL DRILLING by (signature) [Signature]