

WATER WELL PLUGGING RECORD Form WWC-5P

KSA 82a-1212

ID NO.

10300


1 LOCATION OF WATER WELL: County: Sherman	Fraction ¼ sw ¼ nw ¼ nw ¼	Section Number 36	Township Number T 8 S	Range Number 40 <input type="checkbox"/> E <input checked="" type="checkbox"/> W
---	------------------------------	----------------------	--------------------------	---

Street/Rural Address of Well Location; if unknown, distance & direction from nearest town or intersection: If at owner's address, check here CR 18 & 35 1/8 Mile South on East Side

Global Positioning Systems (GPS) information:
 Latitude: ~~36° 19' 19" N~~ 39° 19' 19" N (in decimal degrees)
 Longitude: 101° 44' 655" ~~DRL~~ (in decimal degrees)
 Elevation: _____
 Horizontal Datum: WGS84, NAD83, NAD27
 Collection Method: _____

2 WATER WELL OWNER: Brent Linin
 RR#, St. Address, Box #: 1815 US Hwy 24
 City, State ZIP Code: Goodland KS 67735

GPS unit (Make/Model: Garmin
 Digital Map/Photo, Topographic Map, Land Survey
 Est. Accuracy: < 3 m, 3-5 m, 5-15 m, > 15 m

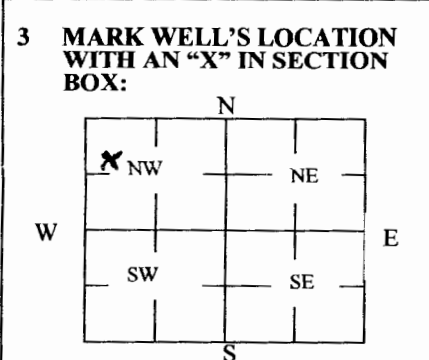

4 DEPTH OF WELL 271 ft.
 WELL'S STATIC WATER LEVEL 199 ft.
 WELL WAS USED AS:

<input type="checkbox"/> Domestic	<input type="checkbox"/> Public Water Supply	<input type="checkbox"/> Dewatering
<input checked="" type="checkbox"/> Irrigation	<input type="checkbox"/> Oil Field Water Supply	<input type="checkbox"/> Monitoring
<input type="checkbox"/> Feedlot	<input type="checkbox"/> Domestic (Lawn & Garden)	<input type="checkbox"/> Injection Well
<input type="checkbox"/> Industrial	<input type="checkbox"/> Air Conditioning	<input type="checkbox"/> Other _____

Was a chemical/bacteriological sample submitted to Department? Yes No

5 TYPE OF BLANK CASING USED:

Steel RMP (SR) Wrought Fiberglass Other (Specify below) _____
 PVC ABS Asbestos-Cement Concrete Tile

Blank casing diameter 16 in. Was casing pulled? Yes No If yes, how much 72" Cut Off
 Casing height above or below land surface 72 below in.

6 GROUT PLUG MATERIAL: Neat cement Cement grout Bentonite Other Native Clays

Grout Plug Intervals: From 120 ft. to 6 ft., From _____ ft. to _____ ft., From _____ ft. to _____ ft.

What is the nearest source of possible contamination:

<input type="checkbox"/> Septic tank	<input type="checkbox"/> Seepage pit	<input type="checkbox"/> Fuel storage	<input type="checkbox"/> Other (specify below) _____
<input type="checkbox"/> Sewer lines	<input type="checkbox"/> Pit privy	<input type="checkbox"/> Fertilizer storage	<input type="checkbox"/> None
<input type="checkbox"/> Watertight sewer lines	<input type="checkbox"/> Sewage lagoon	<input type="checkbox"/> Insecticide storage	
<input type="checkbox"/> Lateral lines	<input type="checkbox"/> Feedyard	<input type="checkbox"/> Abandoned water well	Direction from well? _____
<input type="checkbox"/> Cess pool	<input type="checkbox"/> Livestock pens	<input type="checkbox"/> Oil well/Gas well	How many feet? _____

FROM	TO	PLUGGING MATERIALS	FROM	TO	PLUGGING MATERIALS
271	120	Washed Gravel & HTH			
120	116	Bentonite Chips			
116	6	Native Clays, Drill Cuttings			
6	6	1/4" Steel Plate, Welded			
6	0	Chips and Clays			

7 CONTRACTOR'S OR LANDOWNER'S CERTIFICATION: This water well was plugged under my jurisdiction and was completed on (mo/day/year) 08-03-2016 and this record is true to the best of my knowledge and belief. Kansas Water Well Contractor's License No. 633. This Water Well Record was completed on (mo/day/year) 12-30-2016 under the business name of DMW Well & Pump Service by (signature) Jerry T. Hudnell

Send one white copy to Kansas Department of Health & Environment, Geology Section, 1000 SW Jackson Street, Ste. 420, Topeka, KS 66612-1367. Send one copy to WATER WELL OWNER and retain one for your records.
 Visit us at <http://www.kdheks.gov/waterwell/index.html> Telephone 785-296-5524.