


1 LOCATION OF WATER WELL: Fraction NE 1/4 NW 1/4 SW 1/4 Section Number 34 Township Number T 9 S Range Number 40 E W
 County: Sherman

Street/Rural Address of Well Location; if unknown, distance & direction from nearest town or intersection: If at owner's address, check here 2630 feet North
4140 feet West of Southeast corner of section

Global Positioning Systems (GPS) information:
 Latitude: 39.314737 (in decimal degrees)
 Longitude: -101.778191 (in decimal degrees)
 Elevation: 3736
 Datum: WGS84, NAD83, NAD27
 Collection Method:
 GPS unit (Make/Model: _____)
 Digital Map/Photo, Topographic Map, Land Survey
 Est. Accuracy: <3 m, 3-5 m, 5-15 m, >15 m

2 WATER WELL OWNER: Topliff Revocable Trust
 RR#, St. Address, Box #: 607 Kansas Ave
 City, State ZIP Code: Goodland, Ks 67735

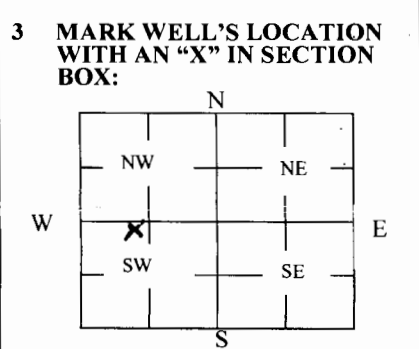

4 DEPTH OF WELL 280 ft.
 WELL'S STATIC WATER LEVEL 170 ft.
 WELL WAS USED AS:
 Domestic Public Water Supply Dewatering
 Irrigation Oil Field Water Supply Monitoring
 Feedlot Domestic (Lawn & Garden) Injection Well
 Industrial Air Conditioning Other _____
 Was a chemical/bacteriological sample submitted to Department? Yes No

5 TYPE OF BLANK CASING USED:
 Steel RMP (SR) Wrought Fiberglass Other (Specify below)
 PVC ABS Asbestos-Cement Concrete Tile
 Blank casing diameter 18 in. Was casing pulled? Yes No If yes, how much Top 5' removed.
 Casing height above or below land surface 60 in.

6 GROUT PLUG MATERIAL: Neat cement Cement grout Bentonite Other _____
 Grout Plug Intervals: From 5 ft. to 15 ft., From _____ ft. to _____ ft., From _____ ft. to _____ ft.
 What is the nearest source of possible contamination:
 Septic tank Seepage pit Fuel storage Other (specify below)
 Sewer lines Pit privy Fertilizer storage
 Watertight sewer lines Sewage lagoon Insecticide storage
 Lateral lines Feedyard Abandoned water well
 Cess pool Livestock pens Oil well Gas well Direction from well? NE
 How many feet? 2103 feet

FROM	TO	PLUGGING MATERIALS	FROM	TO	PLUGGING MATERIALS
15'	160	Sandy Clay	160	280	Chlorinated washed sand and gravel.

7 CONTRACTOR'S OR (LANDOWNER'S) CERTIFICATION: This water well was plugged under my jurisdiction and was completed on (mo/day/year) 12/10/2018 and this record is true to the best of my knowledge and belief. Kansas Water Well Contractor's License No. n/a. This Water Well Record was completed on (mo/day/year) unknown under the business name of unknown by (signature) Randy D. Topliff TTE.

INSTRUCTIONS: Use typewriter or ballpoint pen. Please press firmly and print clearly. Please fill in blanks, underline or circle the correct answers. Send top three copies to Kansas Department of Health and Environment, Bureau of Water, Geology Section, 1000 SW Jackson St., Ste. 420, Topeka, Kansas 66612-1367. Telephone: 785/296-5524. Send one to Water Well Owner and retain one for your records. Visit us at <http://www.kdheks.gov/waterwell/index.html>.