


USE TYPEWRITER OR BALL POINT PEN—PRESS FIRMLY, PRINT CLEARLY.

WATER WELL RECORD
KSA 82a-1201-1215

Kansas Department of Health and Environment—Division of Environment
(Water well Contractors)
Topeka, Kansas 66620

1. Location of well: County Sherman Fraction SE 1/4 SE 1/4 SW 1/4 Section number 9 Township number T 8 S Range number R 40 W E

2. Distance and direction from nearest town or city: 4 miles West one mile North 1/2 mile East of Goodland, Kansas
3. Owner of well: Harlan Dale House
R.R. or street: RFD
City, state, zip code: Goodland, Kansas 67735

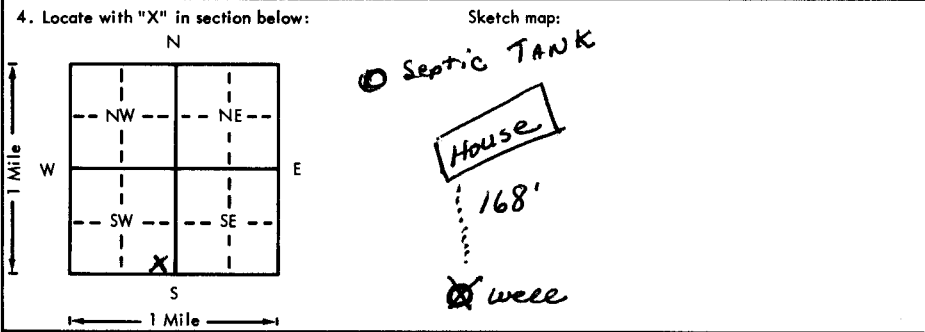

6. Bore hole dia. 8" in. Completion date 2-5-77
Well depth 260 ft.
7. Cable tool Rotary Driven Dug
 Hollow rod Jetted Bored Reverse rotary
8. Use: Domestic Public supply Industry
 Irrigation Air conditioning Stock
 Lawn Oil field water Other
9. Casing: Material plastic Height: Above or below
Threaded Welded gl Surface 18 in.
RMP PVC 180 Weight 180 lbs./ft.
Dia. 4 in. to 260 ft. depth Wall Thickness: inches or
Dia. 4 in. to 260 ft. depth Gauge No. 32

5. Type and color of material

	From	To
clay, rock and sand	0	185
medium to good	185	200
fine sand	200	217
fine sandy clay and fine sand	217	250
blue	250	260
<u>SPON 35'</u>		

10. Screen: Manufacturer's name W. A. Brown
Type plastic Dia. 4
Slot/gauze 1/16 Length 80
Set between 180 ft. and 260 ft.
ft. and _____ ft.
Gravel pack? Size range of material pea
11. Static water level: _____ mo./day/yr.
120 ft. below land surface Date 2-5-77
12. Pumping level below land surfaces:
_____ ft. after _____ hrs. pumping _____ g.p.m.
180 ft. after 3 hrs. pumping 50 g.p.m.
Estimated maximum yield 50 g.p.m.
13. Water sample submitted: _____ mo./day/yr.
Yes No Date _____
14. Well head completion: 18
 Pitless adapter _____ Inches above grade
15. Well grouted? yes
With: Neat cement Bentonite Concrete
Depth: From 0 ft. to 4 ft.
16. Nearest source of possible contamination: none
ft. _____ Direction _____ Type _____
Well disinfected upon completion? _____ Yes No
17. Pump: _____ Not installed
Manufacturer's name Gould
Model number _____ HP 2 Hp Volts 220
Length of drop pipe 200 ft. capacity 50 g.p.m.
Type:
 Submersible Turbine
 Jet Reciprocating
 Centrifugal Other

18. Elevation: _____
Topography: _____ Hill
 Slope
_____ Upland
_____ Valley
19. Remarks: 3190 (TOP)

20. Water well contractor's certification:
This well was drilled under my jurisdiction and this report is true to the best of my knowledge and belief.
Northwest Drilling Co., Inc.
Business name _____ License No. _____
Address Goodland, Kansas
Signed Ben Hart Date 3-22-77
Authorized representative

T-8
R-40E
S-9
SE
SW
1/4
1/4