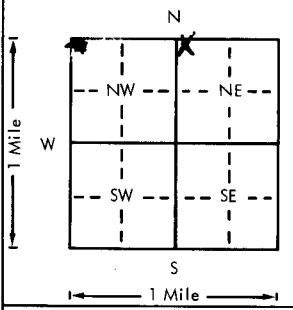
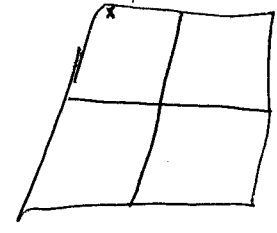


USE TYPEWRITER OR BALL POINT PEN-PRESS FIRMLY, PRINT CLEARLY.

WATER WELL RECORD
KSA 82a-1201-1215

Kansas Department of Health and Environment-Division of Environment (Water well Contractors) Topeka, Kansas 66620

ABB

1. Location of well:	County: SHERMAN	Fraction: N¹/₄ NW¹/₄ No. 1/4	Section number: 11	Township number: T 8 S	Range number: R 40 E/W
2. Distance and direction from nearest town or city: 1W 2N 1/2 W OF HOODLAND			3. Owner of well: DAN DORN R.R. or street: RT 1 City, state, zip code: HOODLAND, KANSAS 67235		
4. Locate with "X" in section below:		Sketch map:		6. Bore hole dia. 4 1/2 in. Completion date 11-20-79 Well depth 278 ft.	
				7. <input checked="" type="checkbox"/> Cable tool <input checked="" type="checkbox"/> Rotary <input type="checkbox"/> Driven <input type="checkbox"/> Dug <input type="checkbox"/> Hollow rod <input type="checkbox"/> Jetted <input type="checkbox"/> Bored <input type="checkbox"/> Reverse rotary	
5. Type and color of material		From	To	8. Use: <input checked="" type="checkbox"/> Domestic <input type="checkbox"/> Public supply <input type="checkbox"/> Industry <input type="checkbox"/> Irrigation <input type="checkbox"/> Air conditioning <input type="checkbox"/> Stock <input type="checkbox"/> Lawn <input type="checkbox"/> Oil field water <input type="checkbox"/> Other	
Sandy clay		0	175	9. Casing: Material Steel Height: <u> </u> Above or below Threaded <input checked="" type="checkbox"/> Welded <input type="checkbox"/> Surface 12 in. RMP <input type="checkbox"/> PVC <input type="checkbox"/> Weight 16.12 lbs./ft. Dia. 4 1/2 in. to 278 ft. depth Wall Thickness: inches or Dia. <u> </u> in. to <u> </u> ft. depth gage No. 188	
Sand		175	197	10. Screen: Manufacturer's name DORRCE Type KEY PUNCH Dia. 4 1/2 Slot/gauze <u> </u> Length 20 FT Set between 258 ft. and 278 ft. <u> </u> ft. and <u> </u> ft. Gravel pack? <input checked="" type="checkbox"/> Size range of material 1/4 x 1/2"	
Sandy clay		197	201	11. Static water level: <u> </u> mo./day/yr. 170 ft. below land surface Date 11-20-79	
Fine sand		201	206	12. Pumping level below land surfaces: 200 ft. after 8 hrs. pumping 10 g.p.m. <u> </u> ft. after <u> </u> hrs. pumping <u> </u> g.p.m. Estimated maximum yield 10 g.p.m.	
Sandstone		206	216	13. Water sample submitted: <u> </u> mo./day/yr. <input type="checkbox"/> Yes <input checked="" type="checkbox"/> No Date <u> </u>	
Fine sand		216	229	14. Well head completion: <input checked="" type="checkbox"/> Pitless adapter 12 Inches above grade	
Sandstone		229	252	15. Well grouted? <input checked="" type="checkbox"/> With: <input checked="" type="checkbox"/> Neat cement <input type="checkbox"/> Bentonite <input type="checkbox"/> Concrete Depth: From 4 ft. to 14 ft.	
Fine sand		252	262	16. Nearest source of possible contamination: ft. <u> </u> Direction NW Type <u> </u> Well disinfected upon completion? <input checked="" type="checkbox"/> Yes <input type="checkbox"/> No	
Hard sandstone		262	264	17. Pump: <input type="checkbox"/> Not installed Manufacturer's name Haulds Model number <u> </u> HP 230 Volts <u> </u> Length of drop pipe 231 ft. capacity 10 g.p.m. Type: <input checked="" type="checkbox"/> Submersible <input type="checkbox"/> Turbine <input type="checkbox"/> Jet <input type="checkbox"/> Reciprocating <input type="checkbox"/> Centrifugal <input type="checkbox"/> Other	
Fine sand		264	278	20. Water well contractor's certification: This well was drilled under my jurisdiction and this report is true to the best of my knowledge and belief. Foust Supply Co Inc 144 Business name License No. 144 Address Box 338 HOODLAND, KANS. 67235 Signed Ralph Elmer Date 12-1 Authorized representative	
18. Elevation:		19. Remarks: BRICK? CONCRETE WAS RUN By Foust Supply Co Inc.		20. Water well contractor's certification: (continued)	
Topography: <input checked="" type="checkbox"/> Hill <input type="checkbox"/> Slope <input type="checkbox"/> Upland <input type="checkbox"/> Valley		(Use a second sheet if needed)			

1-8
 400
 11
 1/4
 1/4
 1/4
 1/4
 Sec