USE TYPEWRITER OR BALL POINT PEN-PRESS FIRMLY, PRINT CLEARLY.

GOODLAND

T	R	EW	sec	1/4	1/4	1/4	No.

WATER WELL RECORD
KSA 82a-1201-1215

DBC

Kansas State Dept. Of Health
(Water Well Contractors)
Forbes-Bldg. 740
Topeka, Kansas 66620

1 Location of well: County	Township name	Fraction	Section number	Town number	Range number
SHERMAN	LOGAN	SW¼ NW¼ SE¼	12	8	40

Distance and direction from nearest town or city: GOODLAND 1½ N ¼ W
Street address of well location if in city:

3 Owner of well: BUFORD HEVNER
Address: GOODLAND KANSAS

Locate with "X" in section below:

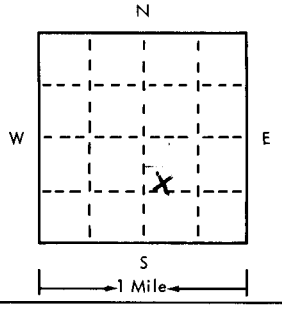

Sketch map:

4 Well depth: 305 ft. Date of completion 5-25-75
Well diameter 8 in.

5 ☐ Cable tool ☒ Rotary ☐ Driven ☐ Dug ☐ Hollow rod ☐ Jetted ☐ Bored ☐ Reverse rotary

6 Use: ☒ Domestic ☐ Public supply ☐ Industry ☐ Irrigation ☐ Air conditioning ☐ Commercial ☐ Test well ☐

7 Casing: Material PLASTIC Height: above/~~below~~
Threaded ☐ Welded ☐ Surface 12 in.
Diam. Weight 200 lbs./ft.
4 in. to 285 ft. depth Drive shoe? ☐ Yes ☒ No
___ in. to ___ ft. depth

2

Type and color of material	From	To
GRAVEL, SANDSTONE	140	145
GRAVEL, SANDY CLAY, SANDSTONE	145	183
CLAY	183	186
SANDY CLAY, SANDSTONE	186	190
GRAVEL	190	204
GRAVEL, SANDY CLAY, SANDSTONE	204	268
CLAY, ROCK	268	270
GRAVEL, SANDY CLAY, SANDSTONE	270	289
GRAVEL	289	292
GRAVEL, SANDY CLAY, SANDSTONE	292	305
BROOK ?		
(use a second sheet if needed)		

8 Screen:
Manufacturer JESS + LOWELL
Type LUVER Dia. 5"
Slot/gauze 18 - .200 Length 20'
Set between 285 ft. and 305 ft.
Fittings:
Gravel pack ☒ Yes ☐ No Size range of material 1/8

9 Static water level:
148 ft. below land surface Date 5-27-75

10 Pumping level below land surfaces:
175 ft. after 3 hrs. pumping 15 g.p.m.
___ ft. after ___ hrs. pumping ___ g.p.m.
Estimated maximum yield 50 g.p.m.

11 Water sample submitted:
☐ Yes ☒ No Date ___

12 Well head completion:
☒ Pitless adapter 12 ☒ Inches above grade

13 Well grouted? ☒ Yes ☐ No
☐ Neat cement ☒ Bentonite ☐ ___
Depth: From 5 ft. to 25 ft.

14 Nearest source of possible contamination:
ft. 250 Direction NW Type Cesspool
Well disinfected upon completion? ☒ Yes ☐ No

15 Pump: ☐ Not installed
Manufacturer's name JACUZZI
Model number UNKNOWN HP 1½ Volts 220
Length of drop pipe 231 ft. capacity 12 g.m.p.
Type:
☒ Submersible ☐ Turbine
☐ Jet ☐ Reciprocating
☐ Centrifugal ☐ Other

16 Remarks: elevation 3671 (TOPO)

Topography:
☐ Hill
☐ Slope
☒ Upland
☐ Valley

17 Water well contractor's certification:
This well was drilled under my jurisdiction and this report is true to the best of my knowledge and belief.
H & H Drilling Co Inc 166
Business name License No.
Address Goodland Kan
Signed Bill Clifford Date 6-17-75
Authorized Representative

Forward the white, blue and pink copies to the Kansas State Dept. Of Health.

Form WWC-5