

USE TYPEWRITER OR BALL POINT PEN-PRESS FIRMLY, PRINT CLEARLY.


WATER WELL RECORD  
KSA 82a-1201-1215

Kansas Department of Health and Environment-Division of Environment  
(Water well Contractors)  
Topeka, Kansas 66620

DIC

1. Location of well: County SHERMAN  Fraction SE 1/4 SE 1/4 SE 1/4 Section number 17 Township number T 8 S R 40 (AN)

2. Distance and direction from nearest town or city: 4 1/2 Mi. W of GOODLAND, KANS. 3. Owner of well: Kenneth Scofield  
R.R. or street: R.R. 2 City, state, zip code: Goodland, Kansas 67735

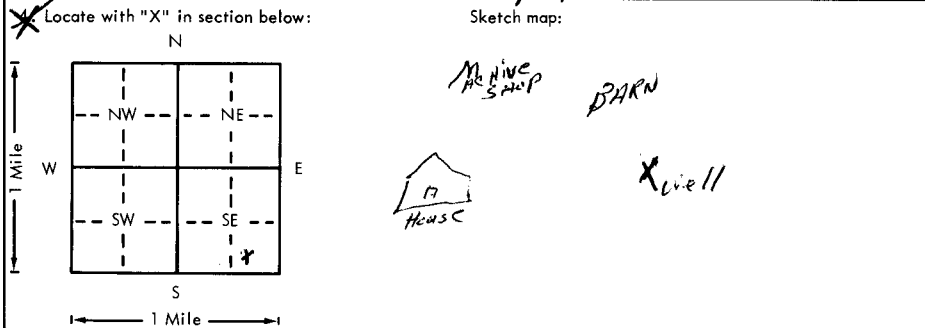

4. Bore hole dia. 10 in. Completion date 10-14-78  
Well depth 457 ft.

7.  Cable tool  Rotary  Driven  Dug  
 Hollow rod  Jetted  Bored  Reverse rotary

8. Use:  Domestic  Public supply  Industry  
 Irrigation  Air conditioning  Stock  
 Lawn  Oil field water  Other

9. Casing: Material STEEL Height: Above or below  
Threaded  Welded  Surface 12 in.  
RMP  PVC  Weight 22 lbs./ft.  
Dia. 4 1/2 in. to 237 ft. depth Wall Thickness: inches or  
Dia. 4 3/8 in. to ft. depth gage No. 1416A

5. Type and color of material	From	To
Top Soil	0	3
Clay	3	156
Sand	156	162
Sandstone	162	210
Sand	210	218
Sandstone	218	224
Sandy clay	224	234
Sand	234	247
Soapstone	247	256
Shale	256	257
BROCK 247'		

10. Screen: Manufacturer's name DOBBER  
SCREEN  
Type millsalt Dia. 4 1/2  
Slot/gauze 4/64 Length 20'  
Set between 237 ft. and 257 ft.  
ft. and ft.  
Gravel pack?  Size range of material 4/4 to 3/8

11. Static water level: 156 ft. below land surface Date 10-14-78 mo./day/yr.

12. Pumping level below land surfaces:  
160 ft. after 8 hrs. pumping 10 g.p.m.  
ft. after hrs. pumping g.p.m.  
Estimated maximum yield 25 g.p.m.

13. Water sample submitted: mo./day/yr.  
 Yes  No Date 10-14-78

14. Well head completion:  
 Pitless adapter 12 Inches above grade

15. Well grouted?   
With:  Neat cement  Bentonite  Concrete  
Depth: From 4' below ft. Below

16. Nearest source of possible contamination:  
1/2 mi. W Direction Type  
Well disinfected upon completion?  Yes  No

17. Pump: Not installed  
Manufacturer's name BOUIDS  
Model number 10 1/2 HP HP 1 Volts 230  
Length of drop pipe 195 ft. capacity 10 g.p.m.  
Type:  
 Submersible  Turbine  
 Jet  Reciprocating  
 Centrifugal  Other

18. Elevation: Topography:  Hill  Slope  Upland  Valley

19. Remarks: Cement Was Run By Foust Supply Co

20. Water well contractor's certification:  
This well was drilled under my jurisdiction and this report is true to the best of my knowledge and belief.  
Foust Supply Co Inc 144  
Business name box License No. 338  
Address 1217  
Signed Robert E. Foust Date 12/7/78  
Authorized representative

- 8 40 W 17 S 1/4 1/4 1/4 1/4