USE TYPEWRITER OR BALL POINT PEN-PRESS FIRMLY, PRINT CLEARLY.

AAD

WATER WELL RECORD
KSA 82a-1201-1215

Kansas Department of Health and Environment-Division of Environment
(Water well Contractors)
Topeka, Kansas 66620

1. Location of well: County	Fraction	Section number	Township number	Range number
Sherman	BC NE 1/4 NE 1/4 NE 1/4 SE	21	T 8 S	R 40 ~~E~~ W

2. Distance and direction from nearest town or city: Goodland
Street address of well location if in city: 3 W 1/8 S

3. Owner of well: Curtis Hurd
R.R. or street: 711 Clark
City, state, zip code: Goodland Kansas 67735

X. Locate with "X" in section below:

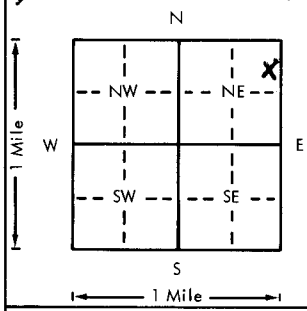

Sketch map:

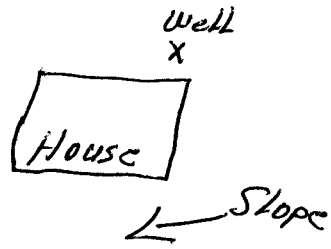

6. Bore hole dia. 8" in. Completion date
Well depth 276 ft. 4-18-79

7. __ Cable tool X Rotary __ Driven __ Dug
__ Hollow rod __ Jetted __ Bored __ Reverse rotary

8. Use: X Domestic __ Public supply __ Industry
__ Irrigation __ Air conditioning __ Stock
__ Lawn __ Oil field water __ Other

9. Casing: Material Plastic Height: Above ~~or below~~
Threaded ___ Welded ___ Surface 12 in.
RMP ___ PVC X Weight ___ lbs./ft.
Dia. 4 in. to 244 ft. depth Wall Thickness: inches or
Dia. ___ in. to ___ ft. depth gage No. 237

5. Type and color of material	From	To
Topsoil	0	4
Clay	4	34
Sandy Clay	34	72
M Gravel Sandy Clay	72	134
Sandy Clay, Sandstone	134	147
M Gravel	147	160
Sandy Clay	160	176
M Gravel	176	191
M Gravel Trace Clay	191	197
Sandy Clay, Sandstone	197	221
M Gravel	221	228
Sandy Clay	228	252
Fine Sand	252	274
Ochre	274	276
BROCK 274'		
(Use a second sheet if needed)		

10. Screen: Manufacturer's name Peerless
Type Louver Dia. 5
Slot/gauze 18 258 Length 32
Set between 244 ft. and 276 ft.
___ ft. and ___ ft.
Gravel pack? ~~Yes~~ Size range of material 18

11. Static water level: mo./day/yr.
145 ft. below land surface Date 4-17-79

12. Pumping level below land surfaces:
170 ft. after 3 hrs. pumping 20 g.p.m.
___ ft. after ___ hrs. pumping ___ g.p.m.
Estimated maximum yield 50 g.p.m.

13. Water sample submitted: mo./day/yr.
__ Yes X No Date

14. Well head completion:
X Pitless adapter 12 Inches above grade

15. Well grouted? yes
With: X Neat cement __ Bentonite __ Concrete
Depth: From 5 ft. to 15 ft.

16. Nearest source of possible contamination: Leach Field
ft. 200 Direction N Type
Well disinfected upon completion? X Yes __ No

17. Pump: __ Not installed
Manufacturer's name Red Jacket
Model number 11 GC HP 1 1/2 Volts 230
Length of drop pipe 231 ft. capacity 20 g.p.m.
Type:
X Submersible __ Turbine
__ Jet __ Reciprocating
__ Centrifugal __ Other

18. Elevation:

Topography:
__ Hill
__ Slope
X Upland
__ Valley

19. Remarks: New Home

20. Water well contractor's certification:
This well was drilled under my jurisdiction and this report is true to the best of my knowledge and belief.
S & H Drilling Inc 166
Business name License No.
Address Goodland Kan.
Signed Bill Clifford Date
Authorized representative 7-19-79

T 8 R 40 Sec 21 NE NE NE 1/4 1/4 1/4

Forward the white, blue and pink copies to the Department of Health and Environment

Form WWC-5