


1 LOCATION OF WATER WELL: County: SHERMAN Fraction: NE 1/4 SW 1/4 NE 1/4 Section Number: 21 Township Number: T 8 S Range Number: R 40 EW

Distance and direction from nearest town or city street address of well if located within city?  
3 mile west on 8th st.

2 WATER WELL OWNER: Sugar Hills Country Club  
 RR#, St. Address, Box #: \_\_\_\_\_  
 City, State, ZIP Code: Goodland, KANSAS, 67735  
 Board of Agriculture, Division of Water Resources  
 Application Number: \_\_\_\_\_

3 LOCATE WELL'S LOCATION WITH AN "X" IN SECTION BOX:

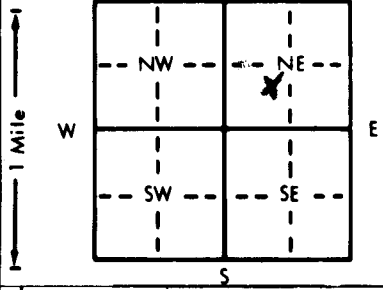

4 DEPTH OF COMPLETED WELL: 310 ft. ELEVATION: \_\_\_\_\_  
 Depth(s) Groundwater Encountered 1. 150 ft. 2. \_\_\_\_\_ ft. 3. \_\_\_\_\_ ft.  
 WELL'S STATIC WATER LEVEL 150 ft. below land surface measured on mo/day/yr Est.  
 Pump test data: Well water was \_\_\_\_\_ ft. after \_\_\_\_\_ hours pumping \_\_\_\_\_ gpm  
 Est. Yield \_\_\_\_\_ gpm: Well water was \_\_\_\_\_ ft. after \_\_\_\_\_ hours pumping \_\_\_\_\_ gpm  
 Bore Hole Diameter 8" in. to 310 ft., and \_\_\_\_\_ in. to \_\_\_\_\_ ft.  
 WELL WATER TO BE USED AS:  
 1 Domestic     3 Feedlot     6 Oil field water supply     9 Dewatering     12 Other (Specify below)  
 2 Irrigation     4 Industrial     7 Lawn and garden only     10 Observation well  
 Was a chemical/bacteriological sample submitted to Department? Yes \_\_\_\_\_ No X; If yes, mo/day/yr sample was submitted \_\_\_\_\_  
 Water Well Disinfected Yes No

5 TYPE OF BLANK CASING USED:  
 1 Steel     3 RMP (SR)     5 Wrought iron     8 Concrete tile    CASING JOINTS: Glued \_\_\_\_\_ Clamped \_\_\_\_\_  
 2 PVC     4 ABS     6 Asbestos-Cement     9 Other (specify below)    \_\_\_\_\_ Welded \_\_\_\_\_  
 \_\_\_\_\_     7 Fiberglass    \_\_\_\_\_ Threaded \_\_\_\_\_  
 Blank casing diameter 4.5 in. to 290 ft., Dia. \_\_\_\_\_ in. to \_\_\_\_\_ ft., Dia. \_\_\_\_\_ in. to \_\_\_\_\_ ft.  
 Casing height above land surface 12 in., weight SDR 26 PVC lbs./ft. Wall thickness or gauge No. 160 P.S.I.

TYPE OF SCREEN OR PERFORATION MATERIAL:  
 1 Steel     3 Stainless steel     5 Fiberglass     8 RMP (SR)     11 Other (specify) \_\_\_\_\_  
 2 Brass     4 Galvanized steel     6 Concrete tile     9 ABS     12 None used (open hole)

SCREEN OR PERFORATION OPENINGS ARE:  
 1 Continuous slot     3 Mill slot     5 Gauzed wrapped     8 Saw cut     11 None (open hole)  
 2 Louvered shutter     4 Key punched     6 Wire wrapped     9 Drilled holes

SCREEN-PERFORATED INTERVALS: From 290 ft. to 310 ft., From \_\_\_\_\_ ft. to \_\_\_\_\_ ft., From \_\_\_\_\_ ft. to \_\_\_\_\_ ft.  
 GRAVEL PACK INTERVALS: From 150 ft. to 310 ft., From \_\_\_\_\_ ft. to \_\_\_\_\_ ft., From \_\_\_\_\_ ft. to \_\_\_\_\_ ft.

6 GROUT MATERIAL:  1 Neat cement     2 Cement grout     3 Bentonite     4 Other \_\_\_\_\_  
 Grout Intervals: From 6 ft. to 26 ft., From \_\_\_\_\_ ft. to \_\_\_\_\_ ft., From \_\_\_\_\_ ft. to \_\_\_\_\_ ft.

What is the nearest source of possible contamination:  
 1 Septic tank     4 Lateral lines     7 Pit privy     11 Fuel storage     14 Abandoned water well  
 2 Sewer lines     5 Cess pool     8 Sewage lagoon     12 Fertilizer storage     15 Oil well/Gas well  
 3 Watertight sewer lines     6 Seepage pit     9 Feedyard     13 Insecticide storage     16 Other (specify below) \_\_\_\_\_

Direction from well? NORTH EAST How many feet? 100' plus

FROM	TO	LITHOLOGIC LOG	FROM	TO	LITHOLOGIC LOG
0	40	SANDY CLAY			
40	100	SANDY CLAY			
100	140	CLAY			
140	220	SANDY CLAY			
240	280	SAND & GRAVEL			
280	310	SAND & GRAVEL			

7 CONTRACTOR'S OR LANDOWNER'S CERTIFICATION: This water well was (1) constructed, (2) reconstructed, or (3) plugged under my jurisdiction and was completed on (mo/day/year) 6-7-89 and this record is true to the best of my knowledge and belief. Kansas Water Well Contractor's License No. 484 This Water Well Record was completed on (mo/day/yr) 6-7-89 under the business name of School Drilling by (signature) Richard School