


1 LOCATION OF WATER WELL: Fraction SW 1/4 SE 1/4 SE 1/4 Section Number 24 Township Number T 8 S Range Number R 40 (EW)
 County: Sherman

Distance and direction from nearest town or city street address of well if located within city?

2 WATER WELL OWNER: Goodland Coop Equity Exchange Board of Agriculture, Division of Water Resources
 RR#, St. Address, Box #: West Hwy 24 MW-6 Application Number:
 City, State, ZIP Code: Goodland, KS

3 LOCATE WELL'S LOCATION WITH AN "X" IN SECTION BOX:

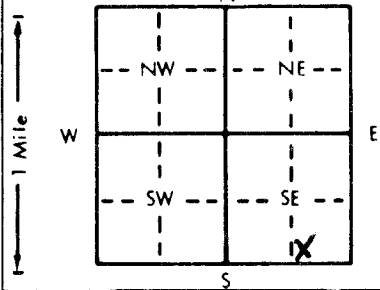

4 DEPTH OF COMPLETED WELL: 202 ft. ELEVATION:
 Depth(s) Groundwater Encountered 1. ft. 2. ft. 3. ft.
 WELL'S STATIC WATER LEVEL 182.55 ft. below land surface measured on mo/day/yr
 Pump test data: Well water was ft. after hours pumping gpm
 Est. Yield gpm: Well water was ft. after hours pumping gpm
 Bore Hole Diameter in. to ft., and in. to ft.
 WELL WATER TO BE USED AS: 5 Public water supply 8 Air conditioning 11 Injection well
 1 Domestic 3 Feedlot 6 Oil field water supply 9 Dewatering 12 Other (Specify below)
 2 Irrigation 4 Industrial 7 Lawn and garden only 10 Monitoring well
 Was a chemical/bacteriological sample submitted to Department? Yes No If yes, mo/day/yr sample was submitted
 Water Well Disinfected? Yes No

5 TYPE OF BLANK CASING USED: 1 Steel 2 PVC 3 RMP (SR) 4 ABS 5 Wrought iron 6 Asbestos-Cement 7 Fiberglass 8 Concrete tile 9 Other (specify below) CASING JOINTS: Glued Clamped
 Blank casing diameter 4 in. to 172 ft., Dia in. to ft., Dia in. to ft.
 Casing height above land surface 0 in., weight lbs./ft. Wall thickness or gauge No.
 TYPE OF SCREEN OR PERFORATION MATERIAL: 1 Steel 2 Brass 3 Stainless steel 4 Galvanized steel 5 Fiberglass 6 Concrete tile 7 PVC 7 PVC 8 RMP (SR) 10 Asbestos-cement 11 Other (specify) 12 None used (open hole)

SCREEN OR PERFORATION OPENINGS ARE: 1 Continuous slot 2 Louvered shutter 3 Mill slot 3 Mill slot 4 Key punched 5 Gauzed wrapped 6 Wire wrapped 7 Torch cut 8 Saw cut 11 None (open hole)
 SCREEN-PERFORATED INTERVALS: From 172 ft. to 202 ft., From ft. to ft.
 GRAVEL PACK INTERVALS: From 170 ft. to 202 ft., From ft. to ft.

6 GROUT MATERIAL: 1 Neat cement 2 Cement grout 2 Cement grout 3 Bentonite 4 Other
 Grout Intervals: From 0 ft. to 1.5 ft., From 1.5 ft. to 168 ft., From 168 ft. to 170 ft.
 What is the nearest source of possible contamination: 1 Septic tank 2 Sewer lines 3 Watertight sewer lines 4 Lateral lines 5 Cess pool 6 Seepage pit 7 Pit privy 8 Sewage lagoon 9 Feedyard 10 Livestock pens 11 Fuel storage 1 Fuel storage 12 Fertilizer storage 13 Insecticide storage 14 Abandoned water well 15 Oil well/Gas well 16 Other (specify below)

Direction from well? How many feet?

FROM	TO	LITHOLOGIC LOG	FROM	TO	PLUGGING INTERVALS
0	0.4	Asphalt			
0.4	20	Silt some clay, dark yellowish brown			
20	31	Clay, some silt dark yellowish brown			
31	51	Clay, dark yellowish brown			
51	79	Sand, fine, clay matrix, light brown			
79	89	Sand, fine, med. yellowish brown			
89	99	Sand, med, mod. yellowish brown			
99	109	Sand, fine, clay matrix, lt brown			
109	119	Sand, med, mod. yellowish brown			
119	139	Sand, fine, some clay matrix lt brown			
139	169	Sand, med, mod. yellowish brown			
169	179	Clay, very pale orange			
179	202	Sand, fine, some clay matrix, lt brown			

7 CONTRACTOR'S OR LANDOWNER'S CERTIFICATION: This water well was (1) constructed, (2) reconstructed, or (3) plugged under my jurisdiction and was completed on (mo/day/year) 2/17/94 and this record is true to the best of my knowledge and belief. Kansas Water Well Contractor's License No. 438 This Water Well Record was completed on (mo/day/yr) 5/31/99 under the business name of Kansas City Testing Lab Inc. by (signature) [Signature]

INSTRUCTIONS: Use typewriter or ball point pen. PLEASE PRESS FIRMLY and PRINT clearly. Please fill in blanks, underline or circle the correct answers. Send top three copies to Kansas Department of Health and Environment, Bureau of Water, Topeka, Kansas 66620-0001. Telephone: 913-296-5545. Send one to WATER WELL OWNER and retain one for your records.