WATER WELL RECORD Form WWC-5 KSA 82a-1212

1 LOCATION OF WATER WELL: County: Sherman | Fraction: SW ¼ SE ¼ SE ¼ | Section Number: 24 | Township Number: T 8 S | Range Number: R 40 E (W)

Distance and direction from nearest town or city street address of well if located within city?

2 WATER WELL OWNER: Goodland Coop Equity Exchange
RR#, St. Address, Box # : West Hwy 24 MW-3 Board of Agriculture, Division of Water Resources
City, State, ZIP Code : Goodland, KS Application Number:

3 LOCATE WELL'S LOCATION WITH AN "X" IN SECTION BOX:

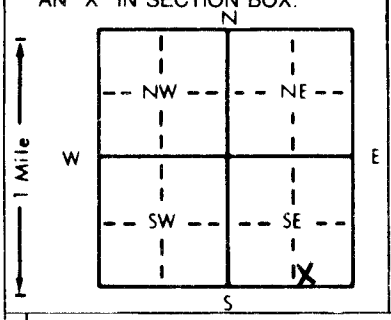


4 DEPTH OF COMPLETED WELL 205 ft. ELEVATION:
Depth(s) Groundwater Encountered 1. ft. 2. ft. 3. ft.
WELL'S STATIC WATER LEVEL 182.57 ft. below land surface measured on mo/day/yr
Pump test data: Well water was ft. after hours pumping gpm
Est. Yield gpm: Well water was ft. after hours pumping gpm
Bore Hole Diameter in. to ft., and in. to ft.
WELL WATER TO BE USED AS: 5 Public water supply 8 Air conditioning 11 Injection well
1 Domestic 3 Feedlot 6 Oil field water supply 9 Dewatering 12 Other (Specify below)
2 Irrigation 4 Industrial 7 Lawn and garden only (10) Monitoring well
Was a chemical/bacteriological sample submitted to Department? Yes (No); If yes, mo/day/yr sample was submitted
Water Well Disinfected? Yes (No)

5 TYPE OF BLANK CASING USED: 1 Steel 3 RMP (SR) 5 Wrought iron 8 Concrete tile 9 Other (specify below)
(2 PVC) 4 ABS 6 Asbestos-Cement 7 Fiberglass
CASING JOINTS: Glued Clamped Welded (Threaded)
Blank casing diameter 4 in. to 175 ft., Dia in. to ft., Dia in. to ft.
Casing height above land surface 0 in., weight lbs./ft. Wall thickness or gauge No.

TYPE OF SCREEN OR PERFORATION MATERIAL: (7 PVC)
1 Steel 3 Stainless steel 5 Fiberglass 8 RMP (SR) 10 Asbestos-cement
2 Brass 4 Galvanized steel 6 Concrete tile 9 ABS 11 Other (specify) 12 None used (open hole)

SCREEN OR PERFORATION OPENINGS ARE: 5 Gauzed wrapped 8 Saw cut 11 None (open hole)
1 Continuous slot (3 Mill slot) 6 Wire wrapped 9 Drilled holes
2 Louvered shutter 4 Key punched 7 Torch cut 10 Other (specify)

SCREEN-PERFORATED INTERVALS: From 175 ft. to 205 ft., From ft. to ft.
From ft. to ft., From ft. to ft.
GRAVEL PACK INTERVALS: From 173 ft. to 203 ft., From ft. to ft.
From ft. to ft., From ft. to ft.

6 GROUT MATERIAL: 1 Neat cement (2 Cement grout) (3 Bentonite) 4 Other
Grout Intervals: From 0 ft. to 15 ft., From 15 ft. to 171 ft., From 171 ft. to 173 ft.

What is the nearest source of possible contamination:
1 Septic tank 4 Lateral lines 7 Pit privy (10 Livestock pens) 14 Abandoned water well
2 Sewer lines 5 Cess pool 8 Sewage lagoon (11 Fuel storage) 15 Oil well/Gas well
3 Watertight sewer lines 6 Seepage pit 9 Feedyard 12 Fertilizer storage 16 Other (specify below)
13 Insecticide storage
Direction from well? How many feet?

| FROM | TO | LITHOLOGIC LOG | FROM | TO | PLUGGING INTERVALS |
|---|---|---|---|---|---|
| 0 | 0.3 | Topsoil | 185 | 205 | Sand, red - coarse grain |
| 0.3 | 10 | Silt, some clay, dark yellowish brown. | | | |
| 10 | 15 | Silt, some clay, grayish orange | | | |
| 15 | 25 | clay, silt, grayish orange. | | | |
| 25 | 40 | clay, silt, brown. | | | |
| 40 | 46 | Clay, some fine to med. sand. | | | |
| 46 | 58 | caliche, very pale orange | | | |
| 58 | 68 | Clayey sand, fine | | | |
| 68 | 88 | Sand | | | |
| 88 | 108 | Sand, clay matrix | | | |
| 108 | 118 | Sand, coarse | | | |
| 118 | 137 | clay, fine sand, light brown. | | | |
| 138 | 168 | Sand, clayey, fine light brown. | | | |
| 168 | 178 | Sand, fine to med. | | | |
| 178 | 185 | Sand, fine, clayey, light brown. | | | |

7 CONTRACTOR'S OR LANDOWNER'S CERTIFICATION: This water well was (1) constructed, (2) reconstructed, or (3) plugged under my jurisdiction and was completed on (mo/day/year) 1/23/94 and this record is true to the best of my knowledge and belief. Kansas Water Well Contractor's License No. 438 This Water Well Record was completed on (mo/day/yr) 5/24/94 under the business name of Kansas City Testing Lab Inc by (signature)

INSTRUCTIONS: Use typewriter or ball point pen. PLEASE PRESS FIRMLY and PRINT clearly. Please fill in blanks, underline or circle the correct answers. Send top three copies to Kansas Department of Health and Environment, Bureau of Water, Topeka, Kansas 66620-0001. Telephone: 913-296-5545. Send one to WATER WELL OWNER and retain one for your records.

OFFICE USE ONLY T R E/W SEC. ¼ ¼ ¼