USE TYPEWRITER OR BALL POINT PEN-PRESS FIRMLY, PRINT CLEARLY.

T R EW sec 1/4 1/4 1/4 No.

WATER WELL RECORD
KSA 82a-1201-1215

Kansas State Dept. Of Health
(Water Well Contractors)
Forbes-Bldg. 740
Topeka, Kansas 66620

BAD

1 Location of well:	County	Township name	Fraction	Section number	Town number	Range number
	Sherman	Logan	NW1/4 NW1/4	24	T8S	R40W

Distance and direction from nearest town or city: Goodland 3/4 W 1/4 S

Street address of well location if in city:

3 Owner of well: S. D. O. Co.

Address: Box 729 Goodland Kansas

Locate with "X" in section below:

Sketch map:

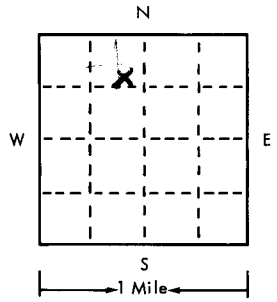

4 Well depth: 293 ft. Date of completion 2-6-75
Well diameter 26 in.

5 ☐ Cable tool ☐ Rotary ☐ Driven ☐ Dug
☐ Hollow rod ☐ Jetted ☐ Bored ☒ Reverse rotary

6 Use: ☐ Domestic ☐ Public supply ☐ Industry
☒ Irrigation ☐ Air conditioning ☐ Commercial
☐ Test well ☐

7 Casing: Material Steel Height: above/~~below~~
Threaded ☐ Welded ☒ Surface 12 in.
Diam. Weight 33 lbs./ft. 1
16 in. to 293 ft. depth Drive shoe? ☐ Yes ☒ No
___ in. to ___ ft. depth

2

Type and color of material	From	To
Fine Sand M Gravel Sandy Clay	160	181
M Gravel	181	188
M Gravel, Sandy Clay, Sandstone	188	235
M Gravel	235	238
Clay Rock	238	250
Fine Sand, Sandstone	250	254
Sandy Clay, Sandstone	254	261
Fine Sand, M Gravel, Sandstone Streaks	261	289
Ochre	289	293
(use a second sheet if needed)		

8 Screen:
Manufacturer W. A Brown
Type Louver Dia. 16
Slot/gauze 18 7 Length 110
Set between 179 ft. and 289 ft.
Fittings:
Gravel pack ☒ Yes ☐ No Size range of material 1/4 x 5/8

9 Static water level:
161 ft. below land surface Date 2-7-75

10 Pumping level below land surfaces:
224 ft. after 8 hrs. pumping 500 g.p.m.
___ ft. after ___ hrs. pumping ___ g.p.m.
Estimated maximum yield 500 g.p.m.

11 Water sample submitted:
☐ Yes ☒ No Date ___

12 Well head completion:
☐ Pitless adapter ☐ Inches above grade

13 Well grouted? ☒ Yes ☐ No
☒ Neat cement ☐ Bentonite ☐ ___
Depth: From 0 ft. to 10 ft.

14 Nearest source of possible contamination:
ft. ___ Direction ___ Type None
Well disinfected upon completion? ☐ Yes ☒ No

15 Pump: ☐ Not installed
Manufacturer's name Western Land Roller
Model number 6M HP 60 Volts 440
Length of drop pipe 280 ft. capacity 500 g.m.p.
Type:
☐ Submersible ☒ Turbine
☐ Jet ☐ Reciprocating
☐ Certrifugal ☐ Other

16 Remarks: elevation 3497 (TOPO)

Topography:
☐ Hill
☐ Slope
☒ Upland
☐ Valley

17 Water well contractor's certification:
This well was drilled under my jurisdiction and this report is true to the best of my knowledge and belief.
S & H Drilling Co Inc 166
Business name License No.
Address Goodland Kansas
Signed Bill Phillips Date 3-6-75
Authorized representative

Forward the white, blue and pink copies to the Kansas State Dept. Of Health.

Form WWC-5