
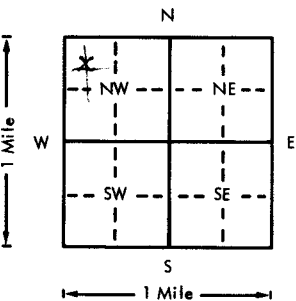
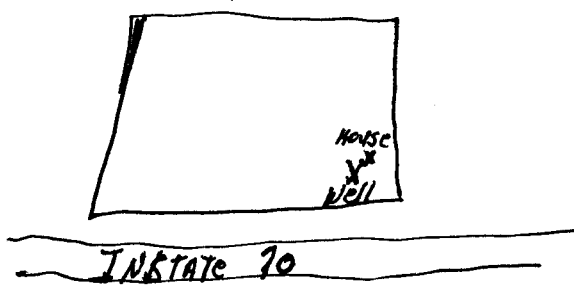


USE TYPEWRITER OR BALL POINT PEN—PRESS FIRMLY, PRINT CLEARLY.

BBB WATER WELL RECORD
KSA 82a-1201-1215
#2 NW 1/4

Kansas Department of Health and Environment—Division of Environment
(Water well Contractors)
Topeka, Kansas 66620

1. Location of well: County SHUMAN		Fraction NW 1/4 26		Section number 26	Township number T 8 S R 40 E W	Range number 40
2. Distance and direction from nearest town or city: 2 West 1/2 South				3. Owner of well: Perry Lohr		
Street address of well location if in city: Goodland Ks.				R.R. or street: Rt. 1		
				City, state, zip code: Goodland Kansas		
4. Locate with "X" in section below:		Sketch map:		6. Bore hole dia. 10 in. Completion date 9-22-77		
				Well depth 275 ft.		
				7. <input checked="" type="checkbox"/> Cable tool <input checked="" type="checkbox"/> Rotary <input type="checkbox"/> Driven <input type="checkbox"/> Dug <input type="checkbox"/> Hollow rod <input type="checkbox"/> Jetted <input type="checkbox"/> Bored <input type="checkbox"/> Reverse rotary		
				8. Use: <input checked="" type="checkbox"/> Domestic <input type="checkbox"/> Public supply <input type="checkbox"/> Industry <input type="checkbox"/> Irrigation <input type="checkbox"/> Air conditioning <input type="checkbox"/> Stock <input type="checkbox"/> Lawn <input type="checkbox"/> Oil field water <input type="checkbox"/> Other		
				9. Casing: Material Steel Height: Above or below Threaded <input checked="" type="checkbox"/> Welded <input type="checkbox"/> Surface 8 in. RMP <input type="checkbox"/> PVC <input type="checkbox"/> Weight 12 lbs./ft. Dia. 4 1/2 in. to 255 ft. depth Wall Thickness: inches or Dia. <input type="checkbox"/> in. to <input type="checkbox"/> ft. depth gage No. 177		
5. Type and color of material				10. Screen: Manufacturer's name DOBBER		
				Type Mi 11 SOFT Dia. 4 1/2		
				Slot/gauze 1/32 Length 20'		
				Set between 255 ft. and 275 ft.		
				Gravel pack? <input checked="" type="checkbox"/> Size range of material 44		
				11. Static water level: 165 ft. below land surface Date 9-21-77		
				12. Pumping level below land surfaces: 200 ft. after 6 hrs. pumping 10 g.p.m. Estimated maximum yield 10 g.p.m.		
				13. Water sample submitted: <input checked="" type="checkbox"/> Yes <input type="checkbox"/> No Date		
				14. Well head completion: <input checked="" type="checkbox"/> Pitless adapter 12 inches above grade		
				15. Well grouted? <input checked="" type="checkbox"/> X With: <input checked="" type="checkbox"/> Neat cement <input type="checkbox"/> Bentonite <input type="checkbox"/> Concrete Depth: From 6 ft. to 10 ft.		
				16. Nearest source of possible contamination: ft. <input type="checkbox"/> Direction <input type="checkbox"/> Type <input type="checkbox"/> Well disinfected upon completion? <input checked="" type="checkbox"/> Yes <input type="checkbox"/> No		
				17. Pump: Not installed Manufacturer's name Go 4105 Model number 10EJ HP <input type="checkbox"/> Volts 230 Length of drop pipe 231 ft. capacity 10 g.p.m. Type: <input checked="" type="checkbox"/> Submersible <input type="checkbox"/> Turbine <input type="checkbox"/> Jet <input type="checkbox"/> Reciprocating <input type="checkbox"/> Centrifugal <input type="checkbox"/> Other		
18. Elevation:		19. Remarks:		20. Water well contractor's certification:		
Topography: <input type="checkbox"/> Hill <input checked="" type="checkbox"/> Slope <input type="checkbox"/> Upland <input type="checkbox"/> Valley		3712 (TOPO) Concrete was Run By Foust Supply Co Inc		This well was drilled under my jurisdiction and this report is true to the best of my knowledge and belief. Foust Supply Co Inc. 144 Business name Box 388 Goodland License No. Address Ralph Elmer Date 9-22-77 Signed Ralph Elmer Authorized Representative		

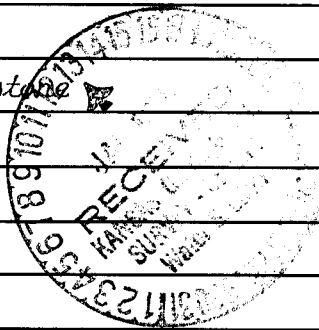

T 8 R 40 E W Sec 26