USE TYPEWRITER OR BALL POINT PEN-PRESS FIRMLY, PRINT CLEARLY.

BCC

WATER WELL RECORD
KSA 82a-1201-1215

Kansas Department of Health and Environment-Division of Environment
(Water well Contractors)
Topeka, Kansas 66620

SW SW NW

1. Location of well:	County: Sherman	Fraction: ~~N.W.~~ 1/4 ~~N.~~ ~~W.~~ 1/4	Section number: 31	Township number: T 8 S	Range number: R 40 E (W)

2. Distance and direction from nearest town or city: 6 WEST 1 SOUTH 1 West ½ NORTH GOODLAND, KANS.
Street address of well location if in city:

3. Owner of well: E.D. or A.S. Ochsner
R.R. or street: 1004 Harrison
City, state, zip code: Goodland Kansas

4. Locate with "X" in section below:

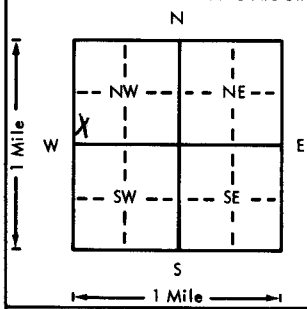

Sketch map:

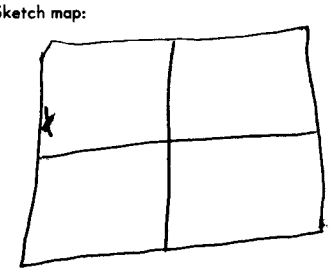

5. Type and color of material	From	To
Clay Sandstone & Gravel	0	149
Gravel	149	151
Sandyclay & Sandstone	151	178
Gravel	178	180
Sandstone & Clay	180	220
Sand	220	225
Sandstone & Sandyclay	225	256
Sand	256	257
Sandstone	257	263
Sand	263	275
Gravel	275	278
Sandyclay	278	289
Gravel	289	291
Soapestone	291	294
Shale BROCK 291'	294	296

(Use a second sheet if needed)

6. Bore hole dia. 10 in. Completion date 4-22-77
Well depth 296 ft.

7. __ Cable tool X Rotary __ Driven __ Dug
__ Hollow rod __ Jetted __ Bored __ Reverse rotary

8. Use: __ Domestic __ Public supply __ Industry
__ Irrigation __ Air conditioning X Stock
__ Lawn __ Oil field water __ Other

9. Casing: Material Steel Height: Above or below
Threaded X Welded ___ Surface 12 in.
RMP ___ PVC ___ Weight 16 lbs./ft.
Dia. 8 in. to 276 ft. depth Wall Thickness: inches or
Dia. ___ in. to ___ ft. depth gage No. .179

10. Screen: Manufacturer's name DOCRA
Type Mill Solt Dia. 4½
Slot/gauze 18 Length 20
Set between 276 ft. and 296 ft.
___ ft. and ___ ft.
Gravel pack? X Size range of material ¼ To ½

11. Static water level: mo./day/yr.
149 ft. below land surface Date 4-22-77

12. Pumping level below land surfaces:
151 ft. after 3 hrs. pumping 10 g.p.m.
___ ft. after ___ hrs. pumping ___ g.p.m.
Estimated maximum yield 10 g.p.m.

13. Water sample submitted: mo./day/yr.
__ Yes X No Date

14. Well head completion:
__ Pitless adapter NONE inches above grade

15. Well grouted? X
With: __ Neat cement __ Bentonite X Concrete
Depth: From 8 IN. to 10 ft.

16. Nearest source of possible contamination:
ft. NONE Direction Type
Well disinfected upon completion? X Yes __ No

17. Pump: X Not installed
Manufacturer's name
Model number HP Volts
Length of drop pipe ft. capacity g.p.m.
Type:
__ Submersible __ Turbine
__ Jet __ Reciprocating
__ Centrifugal __ Other

T 8 R 40 E (W) Sec 31 1/4 SW 1/4 SW 1/4 NW 1/4

18. Elevation:
Topography:
X Hill
__ Slope
__ Upland
__ Valley

19. Remarks:
Concrete Was run By Farmer. Grouting & Slab.

20. Water well contractor's certification:
This well was drilled under my jurisdiction and this report is true to the best of my knowledge and belief.
Foust Supply Co Inc License No. 144
Business name
Address Box 338 Goodland
Signed Ralph Elfner Date 5-5-77
Authorized representative

Forward the white, blue and pink copies to the Department of Health and Environment

Form WWC-5