


1 LOCATION OF WATER WELL: County: Sherman Fraction: SE 1/4 SE 1/4 SW 1/4 Section Number: 21 Township Number: T 8 S Range Number: R 41 EW

Distance and direction from nearest town or city street address of well if located within city?
8 1/2 West of Goodland

2 WATER WELL OWNER: Robert Shampow
 RR#, St. Address, Box #: 6497 rd 16
 City, State, ZIP Code: Goodland KS 67735
 Board of Agriculture, Division of Water Resources
 Application Number:

3 LOCATE WELL'S LOCATION WITH AN "X" IN SECTION BOX:

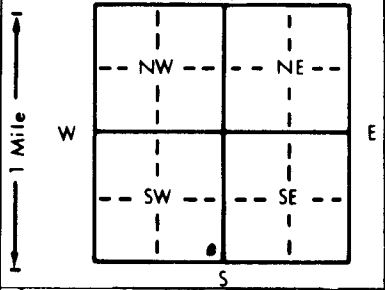

4 DEPTH OF COMPLETED WELL: 260 ft. ELEVATION:

Depth(s) Groundwater Encountered 1. 165 ft. 2. 165 ft. 3. ft.
 WELL'S STATIC WATER LEVEL 165 ft. below land surface measured on mo/day/yr
 Pump test data: Well water was ft. after hours pumping gpm
 Est. Yield 20 gpm: Well water was ft. after hours pumping gpm
 Bore Hole Diameter 8 in. to 260 ft., and in. to ft.
 WELL WATER TO BE USED AS: 5 Public water supply 8 Air conditioning 11 Injection well
 1 Domestic 3 Feedlot 6 Oil field water supply 9 Dewatering 12 Other (Specify below)
 2 Irrigation 4 Industrial 7 Lawn and garden only 10 Monitoring well
 Was a chemical/bacteriological sample submitted to Department? Yes No If yes, mo/day/yr sample was submitted
 Water Well Disinfected? Yes No

5 TYPE OF BLANK CASING USED: 1 Steel 3 RMP (SR) 5 Wrought iron 8 Concrete tile CASING JOINTS: Glued Clamped
 2 PVC 4 ABS 6 Asbestos-Cement 9 Other (specify below) Welded
 Blank casing diameter 4.5 in. to 240 ft., Dia. in. to ft., Dia. in. to ft.
 Casing height above land surface 12 in., weight 160 psi lbs./ft. Wall thickness or gauge No. 3DR26
 TYPE OF SCREEN OR PERFORATION MATERIAL: 7 PVC 10 Asbestos-cement
 1 Steel 3 Stainless steel 5 Fiberglass 8 RMP (SR) 11 Other (specify)
 2 Brass 4 Galvanized steel 6 Concrete tile 9 ABS 12 None used (open hole)

SCREEN OR PERFORATION OPENINGS ARE: 5 Gauzed wrapped 8 Saw cut 11 None (open hole)
 1 Continuous slot 3 Mill slot 6 Wire wrapped 9 Drilled holes
 2 Louvered shutter 4 Key punched 7 Torch cut 10 Other (specify)

SCREEN-PERFORATED INTERVALS: From 240 ft. to 260 ft., From ft. to ft.
Silica Sand From ft. to ft., From ft. to ft.
 GRAVEL PACK INTERVALS: From 200 ft. to 260 ft., From ft. to ft.
Peagavel From 20 ft. to 200 ft., From ft. to ft.

6 GROUT MATERIAL: 1 Neat cement 2 Cement grout 3 Bentonite 4 Other
 Grout intervals: From 0 ft. to 20 ft., From ft. to ft., From ft. to ft.

What is the nearest source of possible contamination:
 1 Septic tank 4 Lateral lines 7 Pit privy 10 Livestock pens 14 Abandoned water well
 2 Sewer lines 5 Cess pool 8 Sewage lagoon 11 Fuel storage 15 Oil well/Gas well
 3 Watertight sewer lines 6 Seepage pit 9 Feedyard 12 Fertilizer storage 16 Other (specify below)
 13 Insecticide storage

Direction from well? None in view How many feet?

FROM	TO	LITHOLOGIC LOG	FROM	TO	PLUGGING INTERVALS
0	10	Overburden			
10	30	Clay			
30	90	gravel			
90	120	Sand + clay			
120	140	gravel-sand + clay			
140	220	Sand + clay			
220	240	Sand			
240	260	gravel + sand			
	260	Shale			

7 CONTRACTOR'S OR LANDOWNER'S CERTIFICATION: This water well was (1) constructed, (2) reconstructed, or (3) plugged (under my jurisdiction and was completed on (mo/day/year) 9-6-97 and this record is true to the best of my knowledge and belief. Kansas Water Well Contractor's License No. 484 This Water Well Record was completed on (mo/day/yr) 9-19-97 under the business name of Schaal Drilling Co. by (signature) Robert Shampow