

USE TYPEWRITER OR BALL POINT PEN-PRESS FIRMLY, PRINT CLEARLY.

RULED 1 W

T R EW sec 1/4 1/4 1/4 No.


WATER WELL RECORD
KSA 82a-1201-1215

Kansas State Dept. Of Health
(Water Well Contractors)
Forbes-Bldg. 740
Topeka, Kansas 66620

BBB

1 Location of well: County SHERMAN Township name GRANT Fraction NW 1/4 Section number 7 Town number 8 Range number 41

Distance and direction from nearest town or city: 4 mile north + 3 Owner of well: Rex HICKSON
Street address of well location if in city: 3 west Rulton Address: KANORADO, KANS.

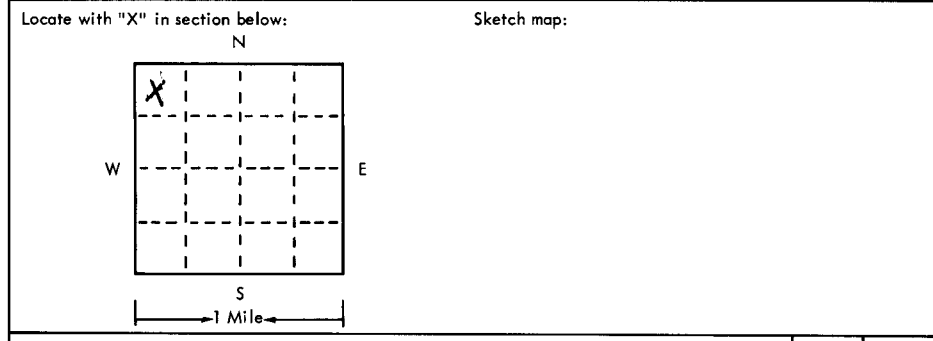

4 Well depth: 263 ft. Date of completion 4-16-75
Well diameter 16 in.
5 Cable tool Rotary Driven Dug
 Hollow rod Jetted Bored Reverse rotary
6 Use: Domestic Public supply Industry
 Irrigation Air conditioning Commercial
 Test well
7 Casing: Material Steel Height: above below
Threaded Welded Surface 8 in.
Diam. 16 in. Weight 27 lbs./ft.
16 in. to 263 ft. depth Drive shoe? Yes No

2	Type and color of material	From	To
	GRAVEL	113	129
	CLAY	129	133
	GRAVEL	133	145
	SANDSTONE	145	170
	SAND	170	185
	CLAY	185	187
	SAND	187	197
	SANDSTONE	197	206
	SAND	206	231
	SANDSTONE	231	239
	GRAVEL	239	253
	SOAPSTONE	253	261
	SHALE	261	263
	BRONZE		

8 Screen: Manufacturer W.A. BROWN
Type Mill salt Dia. 16"
Slot/gauze 1/8 Length 2 1/2
Set between 147 ft. and 263 ft.
Fittings: Gravel pack Yes No Size range of material 1/8"
9 Static water level: 113 ft. below land surface Date 4-16-75
10 Pumping level below land surfaces:
200 ft. after 20 hrs. pumping 200 g.p.m.
____ ft. after ____ hrs. pumping ____ g.p.m.
Estimated maximum yield 850 g.p.m.
11 Water sample submitted:
 Yes No Date ____
12 Well head completion:
 Pitless adapter Inches above grade
13 Well grouted? Yes No
 Neat cement Bentonite _____
Depth: From 8" ft. to 12 ft.
14 Nearest source of possible contamination:
ft. ____ Direction ____ Type ____
Well disinfected upon completion? Yes No
15 Pump: Not installed
Manufacturer's name AVC TAIT
Model number ____ HP ____ Volts ____
Length of drop pipe 250 ft. capacity 850 g.p.m.
Type:
 Submersible Turbine
 Jet Reciprocating
 Centrifugal Other

16 Remarks: elevation 3804 (TOP)

Topography:
 Hill
 Slope
 Upland
 Valley

17 Water well contractor's certification:
This well was drilled under my jurisdiction and this report is true to the best of my knowledge and belief.
Foust Supply Co Inc 144
Business name License No. ____
Address Box 238 Goodland
Signed Ralph Egan Date 4-30-75
Authorized representative