

USE TYPEWRITER OR BALL POINT PEN-PRESS FIRMLY, PRINT CLEARLY.


WATER WELL RECORD
KSA 82a-1201-1215

Kansas Department of Health and Environment-Division of Environment (Water well Contractors) Topeka, Kansas 66620

CAC

1. Location of well: County SHERMAN Fraction N¹/₂ SW¹/₄ ~~SW¹/₄~~ SW¹/₄ Section number 13 Township number T 8 S R 41 E (M)

2. Distance and direction from nearest town or city: 6 W. 1/4 W. of Goodland, KANS.
Street address of well location if in city:
3. Owner of well: DWIGHT Bruney
R.R. or street: RT 1
City, state, zip code: GOODLAND, KANSAS

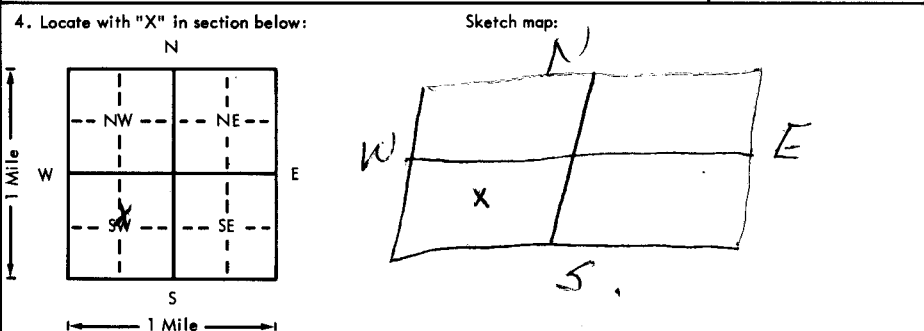

6. Bore hole dia. 16 in. Completion date 1-14-76
Well depth 281 ft.

7. Cable tool Rotary Driven Dug
Hollow rod Jetted Bored Reverse rotary

8. Use: Domestic Public supply Industry
 Irrigation Air conditioning Stock
Lawn Oil field water Other

9. Casing: Material Steel Height: Above or below
Threaded Welded Surface 8" in.
RMP PVC Weight 37 lbs./ft.
Dia. 16 in. to 281 ft. depth Wall Thickness: inches or
Dia. in. to ft. depth gage No. 188

5. Type and color of material	From	To
Top Soil	0	3
Clay Sandstone & Gravel	3	140
Gravel	140	148
Clay & Sandstone	148	161
Gravel	161	163
Sandstone & Clay	163	195
Gravel	195	198
Sandstone & Clay	198	212
Fine Sand	212	220
Sandstone	220	222
Gravel	222	229
Clay & Sandstone	229	237
Sand	237	242
Sandy clay	242	251
Gravel	251	270
Shale	270	278

10. Screen: Manufacturer's name W. A. BROWN
Type Millsalt Dia. 16"
Slot/gauze 1/8 Length 120'
Set between 120 ft. and 280 ft.
ft. and ft.
Gravel pack? Size range of material 3/8

11. Static water level: 140 ft. below land surface Date 1-14-76 mo./day/yr.

12. Pumping level below land surfaces:
180 ft. after 7 hrs. pumping 700 g.p.m.
260 ft. after 15 hrs. pumping 845 g.p.m.
Estimated maximum yield 845 g.p.m.

13. Water sample submitted: mo./day/yr.
Yes No Date

14. Well head completion:
 Pitless adapter Inches above grade

15. Well grouted?
With: Neat cement Bentonite Concrete
Depth: From 10 ft. to 8" + Above

16. Nearest source of possible contamination:
ft. Direction NE Type
Well disinfected upon completion? Yes No

17. Pump: Not installed
Manufacturer's name AFC TAIT
Model number 126cm HP 125 Volts 460
Length of drop pipe 270 ft. capacity 845 g.p.m.
Type:
 Submersible Turbine
 Jet Reciprocating
 Centrifugal Other

18. Elevation:
19. Remarks: BROCK 270'
Topography:
 Hill
 Slope
 Upland
 Valley

20. Water well contractor's certification:
This well was drilled under my jurisdiction and this report is true to the best of my knowledge and belief.
Business name Foult Supply Co Inc License No. 144
Address Box 338 Goodland
Signed RALPH JEAN USA Date 3-31-76
Authorized representative

T 8
R 41
E
S
W
1/4
1/4
SW
1/4