

USE TYPEWRITER OR BALL POINT PEN-PRESS FIRMLY, PRINT CLEARLY.


AAA

WATER WELL RECORD  
KSA 82a-1201-1215

Kansas Department of Health and Environment-Division of Environment  
(Water well Contractors)  
Topeka, Kansas 66620

1. Location of well: County Sherman Fraction NE 1/4 Ne 1/4 NE 1/4 Section number 19 Township number T 8 S R 41 W E/W

2. Distance and direction from nearest town or city: 2 Miles West 1 Mile 3. Owner of well: Ben Duell  
Street address of well location if in city: North Of Ruleton Ks. R.R. or street: Ruleton Kansas 67735  
City, state, zip code: Ruleton Kansas 67735

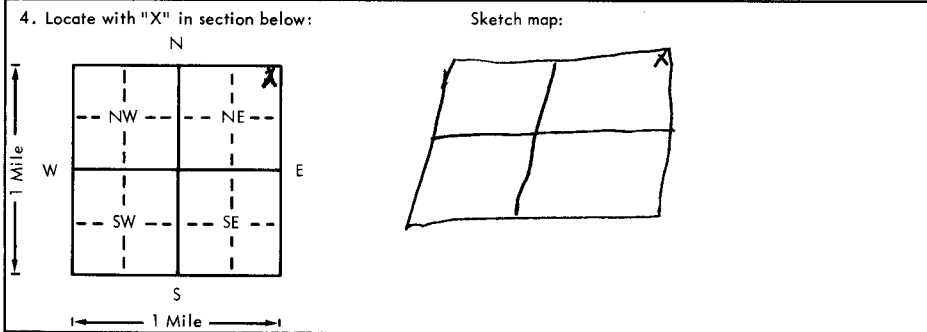

6. Bore hole dia. 10 in. Completion date 9-16-78  
Well depth 295 ft.  
7.  Cable tool  Rotary  Driven  Dug  
 Hollow rod  Jetted  Bored  Reverse rotary  
8. Use:  Domestic  Public supply  Industry  
 Irrigation  Air conditioning  Stock  
 Lawn  Oil field water  Other  
9. Casing: Material steel Height: Above or below  
Threaded  Welded  Surface 12 in.  
RMP  PVC  Weight 16 lbs./ft.  
Dia. 4 1/2 in. to 225 ft. depth Wall Thickness: inches or  
Dia.     in. to     ft. depth gage No. 179

5. Type and color of material	From	To
Top Soil	0	3
Clay	3	125
Sandy clay	125	132
Sand	132	161
Sandstone	161	172
Sand	172	207
Sandy clay	207	228
Sand	228	288
Soapstone	288	294
Shale	294	295
BROCK 288'		

10. Screen: Manufacturer's name DORRERS  
Type key punch Dia. 4 1/2  
Slot/gauze 32 Length 20'  
Set between 275 ft. and 295 ft.  
ft. and     ft.  
Gravel pack?  Size range of material 18-38  
11. Static water level: 152 ft. below land surface Date 9/16-78 mo./day/yr.  
12. Pumping level below land surfaces:  
150 ft. after 8 hrs. pumping 10 g.p.m.  
    ft. after     hrs. pumping     g.p.m.  
Estimated maximum yield 25 g.p.m.  
13. Water sample submitted:     mo./day/yr.  
 Yes  No Date      
14. Well head completion:  
 Pitless adapter 12 Inches above grade  
15. Well grouted?   
With:  Neat cement  Bentonite  Concrete  
Depth: From 4 ft. to 14 ft.  
16. Nearest source of possible contamination:  
ft.     Direction     Type      
Well disinfected upon completion?  Yes  No  
17. Pump:  Not installed  
Manufacturer's name Hou 105  
Model number 405 HP 1 Volts 230  
Length of drop pipe 225 ft. capacity 10 g.p.m.  
Type:  
 Submersible  Turbine  
 Jet  Reciprocating  
 Centrifugal  Other

18. Elevation: Topography:  Hill  Slope  Upland  Valley  
19. Remarks: Cement Was Run By Foust Supply Co. Inc.  
20. Water well contractor's certification:  
This well was drilled under my jurisdiction and this report is true to the best of my knowledge and belief.  
For Supply Co. Inc. 144  
Business name 144 License No.      
Address 24338 Woodland Lane  
Signed Edith D. Foust Date 2-21-79  
Authorized representative

- 03 410 19 NE NENE 1/4 1/4 1/4