USE TYPEWRITER OR BALL POINT PEN-PRESS FIRMLY, PRINT CLEARLY.

CDD

WATER WELL RECORD
KSA 82a-1201-1215

Kansas Department of Health and Environment-Division of Environment
(Water well Contractors)
Topeka, Kansas 66620

1. Location of well:	County	Fraction	Section number	Township number	Range number
	SHERMAN	SE 1/4 SE 1/4 SW 1/4	19	T 8 S	R 41 W

2. Distance and direction from nearest town or city: Goodland
Street address of well location if in city: 11½ W

3. Owner of well: PRIME PORK PRODUCERS
R.R. or street: RR1
City, state, zip code: GOODLAND KANSAS

4. Locate with "X" in section below:

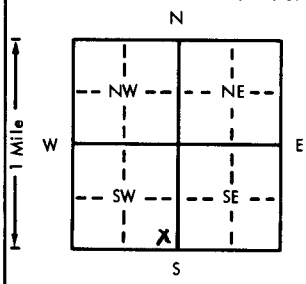

Sketch map:

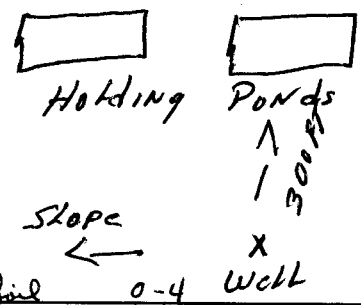

6. Bore hole dia. 8 in. Completion date 1-29-76
Well depth 293 ft.

7. __ Cable tool X Rotary __ Driven __ Dug
__ Hollow rod __ Jetted __ Bored __ Reverse rotary

8. Use: X Domestic __ Public supply __ Industry
__ Irrigation __ Air conditioning __ Stock
__ Lawn __ Oil field water __ Other

9. Casing: Material Plastic Height: Above ~~or below~~
Threaded __ Welded __ Surface 12 in.
RMP __ PVC X Weight __ lbs./ft.
Dia. 4 in. to 223 ft. depth Wall Thickness: inches or
Dia. __ in. to __ ft. depth gage No. .200-.237

5. Type and color of material: Top soil 0-4; Clay, f. sand 4-73; sandy clay, m. gravel 73-120

Material	From	To
M GRAVEL	120	146
M GRAVEL, SANDY CLAY	146	161
M GRAVEL	161	171
M GRAVEL, SANDY CLAY, SANDSTONE	171	211
FINE SAND, SANDSTONE	211	219
FINE SAND, SANDY CLAY	219	234
FINE SAND	234	238
FINE SAND, SANDY CLAY, SANDSTONE	238	272
SANDY CLAY	272	282
M GRAVEL	282	287
OCHRE	287	293
BROCK 287'		

(Use a second sheet if needed)

10. Screen: Manufacturer's name Jessy Lowell
Type Luren Dia. 5
Slot/gauze 1/8, .200-.250 Length 30
Set between 273 ft. and 293 ft.
__ ft. and __ ft.
Gravel pack? yes Size range of material 1/8

11. Static water level: mo./day/yr.
129 ft. below land surface Date 1-30-76

12. Pumping level below land surfaces:
140 ft. after 3 hrs. pumping 10 g.p.m.
__ ft. after __ hrs. pumping __ g.p.m.
Estimated maximum yield 50 g.p.m.

13. Water sample submitted: mo./day/yr.
__ Yes X No Date

14. Well head completion:
X Pitless adapter 12 Inches above grade

15. Well grouted? yes
With: X Neat cement __ Bentonite X Concrete
Depth: From 5 ft. to 15 ft.

16. Nearest source of possible contamination: Holding Ponds
ft. 300 Direction N Type
Well disinfected upon completion? X Yes __ No

17. Pump: Not installed
Manufacturer's name Red Jacket
Model number 14BC HP 1 Volts 220
Length of drop pipe 192 ft. capacity 10 g.p.m.
Type:
X Submersible __ Turbine
__ Jet __ Reciprocating
__ Centrifugal __ Other

T 8 R 41 (W) Sec 19 SE 1/4 SE 1/4 SW 1/4

18. Elevation:
Topography:
__ Hill
__ Slope
X Upland
__ Valley

19. Remarks:

20. Water well contractor's certification:
This well was drilled under my jurisdiction and this report is true to the best of my knowledge and belief.
Business name L & H Drilling Co Inc License No. 166
Address Goodland Kansas
Signed Bill Clifford Authorized representative Date 2-12-76

Forward the white, blue and pink copies to the Department of Health and Environment

Form WWC-5