


1 LOCATION OF WATER WELL: Fraction NW 1/4 NW 1/4 SW 1/4 Section Number 22 Township Number T 8 S Range Number R 41 E
 County: SHERMAN

Distance and direction from nearest town or city street address of well if located within city?
At Rubeton

2 WATER WELL OWNER: CRAIG MANN
 RR#, St. Address, Box # : Rt-3 Board of Agriculture, Division of Water Resources
 City, State, ZIP Code : Goodland, KANSAS Application Number:

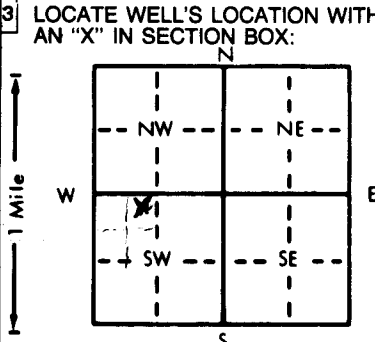

4 DEPTH OF COMPLETED WELL 270 ft. ELEVATION: _____
 Depth(s) Groundwater Encountered 1. 250 ft. 2. _____ ft. 3. _____ ft.
 WELL'S STATIC WATER LEVEL 158 ft. below land surface measured on mo/day/yr 9-15-89
 Pump test data: Well water was _____ ft. after _____ hours pumping _____ gpm
 Est. Yield 15 gpm: Well water was _____ ft. after _____ hours pumping _____ gpm
 Bore Hole Diameter 8" in. to _____ ft., and _____ in. to _____ ft.
 WELL WATER TO BE USED AS:
 1 Domestic 3 Feedlot 6 Oil field water supply 9 Dewatering 12 Other (Specify below)
 2 Irrigation 4 Industrial 7 Lawn and garden only 10 Monitoring well
 Was a chemical/bacteriological sample submitted to Department? Yes _____ No _____; If yes, mo/day/yr sample was sub-
 mitted _____ Water Well Disinfected? Yes No _____

5 TYPE OF BLANK CASING USED:
 1 Steel 3 RMP (SR) 5 Wrought iron 8 Concrete tile CASING JOINTS: Glued _____ Clamped
 2 PVC 4 ABS 6 Asbestos-Cement 9 Other (specify below) _____ Welded
 _____ _____ 7 Fiberglass _____ Threaded
 Blank casing diameter _____ in. to _____ ft., Dia _____ in. to _____ ft., Dia _____ in. to _____ ft.
 Casing height above land surface 12 in., weight 160# lbs./ft. Wall thickness or gauge No. SR 26
 TYPE OF SCREEN OR PERFORATION MATERIAL:
 1 Steel 3 Stainless steel 5 Fiberglass 7 PVC 10 Asbestos-cement
 2 Brass 4 Galvanized steel 6 Concrete tile 9 ABS 11 Other (specify) _____
 _____ _____ _____ 8 Saw cut 12 None used (open hole)
 SCREEN OR PERFORATION OPENINGS ARE:
 1 Continuous slot 3 Mill slot 5 Gauzed wrapped 9 Drilled holes
 2 Louvered shutter 4 Key punched 6 Wire wrapped 10 Other (specify) _____
 _____ _____ _____ _____
 SCREEN-PERFORATED INTERVALS: From 250 ft. to 270 ft., From _____ ft. to _____ ft.
 GRAVEL PACK INTERVALS: From 100 ft. to 270 ft., From _____ ft. to _____ ft.
 From _____ ft. to _____ ft., From _____ ft. to _____ ft.

6 GROUT MATERIAL: 1 Neat cement 2 Cement grout 3 Bentonite 4 Other Clay
 Grout Intervals: From 5 ft. to 25 ft., From 25 ft. to 100 ft., From _____ ft. to _____ ft.
 What is the nearest source of possible contamination:
 1 Septic tank 4 Lateral lines 7 Pit privy 10 Livestock pens 14 Abandoned water well
 2 Sewer lines 5 Cess pool 8 Sewage lagoon 11 Fuel storage 15 Oil well/Gas well
 3 Watertight sewer lines 6 Seepage pit 9 Feedyard 12 Fertilizer storage 16 Other (specify below)
 _____ _____ _____ _____ _____
 Direction from well? 300' South How many feet? 300'

FROM	TO	LITHOLOGIC LOG	FROM	TO	PLUGGING INTERVALS
0	20	Clay			
20	100	SAND + CLAY LAYERS			
100	250	SAND + GRAVEL VERY LITTLE CLAY LENSES LOTS WATER LOSS			
250	270	SAND + GRAVEL			
270		Shale			

Well Drilling only, no pump installed by U.S.

7 CONTRACTOR'S OR LANDOWNER'S CERTIFICATION: This water well was (1) constructed, (2) reconstructed, or (3) plugged under my jurisdiction and was completed on (mo/day/year) 9-20-89 and this record is true to the best of my knowledge and belief. Kansas Water Well Contractor's License No. 484 This Water Well Record was completed on (mo/day/yr) 9-20-89 under the business name of Schaal Drilling Co. by (signature) Ruben Schaal