

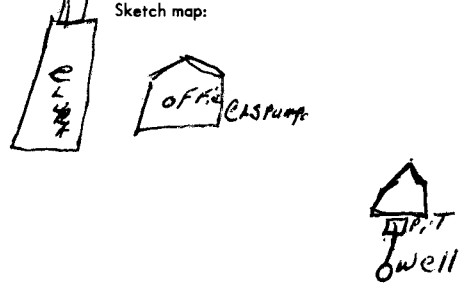
USE TYPEWRITER OR BALL POINT PEN-PRESS FIRMLY, PRINT CLEARLY.

WATER WELL RECORD
KSA 82a-1201-1215

Kansas Department of Health and Environment-Division of Environment
(Water well Contractors)
Topeka, Kansas 66620

1. Location of well: County NEK SHERMAN Fraction SW 1/4 1/4 SW 1/4 Section number 22 Township number T 8 Range number S R 41 E W

2. Distance and direction from nearest town or city: _____
Street address of well location if in city: _____
3. Owner of well: Ruleton Cool
R.R. or street: _____
City, state, zip code: Ruleton, Kans. 67735

4. Locate with "X" in section below:
N
NW NE
SW SE
S
W E
1 Mile
Sketch map:


6. Bore hole dia. 10 3/4 in. Completion date 8-8-26
Well depth 245 ft.
7. Cable tool Rotary Driven Dug
 Hollow rod Jetted Bored Reverse rotary
8. Use: Domestic Public supply Industry
 Irrigation Air conditioning Stock
 Lawn Oil field water Other
9. Casing: Material Steel Height: Above or below
Threaded Welded Surface 12 in.
RMP PVC Weight 16 lbs./ft.
Dia. 1/2 in. to 220 ft. depth Wall Thickness: inches or
Dia. in. to ft. depth gage No. 179

5. Type and color of material	From	To
<u>Clay Sandstone & Gravel</u>	<u>0</u>	<u>106</u>
<u>Gravel</u>	<u>106</u>	<u>113</u>
<u>Sandstone & Clay</u>	<u>113</u>	<u>145</u>
<u>Gravel</u>	<u>145</u>	<u>150</u>
<u>Clay & Sandstone</u>	<u>150</u>	<u>189</u>
<u>Gravel</u>	<u>189</u>	<u>197</u>
<u>Sandstone & Clay</u>	<u>197</u>	<u>225</u>
<u>Sand</u>	<u>225</u>	<u>235</u>
<u>Gravel</u>	<u>235</u>	<u>236</u>
<u>Soapstone</u>	<u>236</u>	<u>245</u>
<u>Shale</u>	<u>245</u>	
<u>Rock 736</u>		

10. Screen: Manufacturer's name DOBERR
Type Mill salt Dia. 4 1/2
Slot/gauze 1/32 Length 25
Set between 220 ft. and 245 ft.
ft. and _____ ft.
Gravel pack? Size range of material 1/4 X 3/8
11. Static water level: _____ mo./day/yr.
106 ft. below land surface Date 8-8-26
12. Pumping level below land surfaces:
120 ft. after 8 hrs. pumping 10 g.p.m.
_____ ft. after _____ hrs. pumping _____ g.p.m.
Estimated maximum yield 10 g.p.m.
13. Water sample submitted: _____ mo./day/yr.
 Yes No Date _____
14. Well head completion:
 Pitless adapter 8 Inches above grade
15. Well grouted?
With: _____ Neat cement Bentonite _____ Concrete
Depth: From 9 ft. to 14 ft.
16. Nearest source of possible contamination:
ft. 1000 Direction SW Type GAS
Well disinfected upon completion? Yes _____ No
17. Pump: _____ Not installed
Manufacturer's name Coults
Model number _____ HP 3/4 Volts 230
Length of drop pipe 160 ft. capacity 10 g.p.m.
Type:
 Submersible _____ Turbine
 Jet _____ Reciprocating
 Centrifugal _____ Other

18. Elevation: _____
19. Remarks: 3960 (1000)
Concrete was run to depth 14 ft by Foust Supply Co.
20. Water well contractor's certification:
This well was drilled under my jurisdiction and this report is true to the best of my knowledge and belief.
Foust Supply Co. Inc. 144
Business name _____ License No. _____
Address 80 N 338 Goodland, Kans
Signed Ralph Chman Date 2-25-71
Authorized representative