

USE TYPEWRITER OR BALL POINT PEN—PRESS FIRMLY, PRINT CLEARLY.

WELL

T R EW sec 1/4 1/4 1/4 No.

WATER WELL RECORD
KSA 82a-1201-1215


Kansas State Dept. Of Health
(Water Well Contractors)
Forbes-Bldg. 740
Topeka, Kansas 66620

PCB

1 Location of well: County SHERMAN Township name LINCOLN Fraction SOUTH NORTH Section number 28 Town number 8 Range number 41

Distance and direction from nearest town or city: Ruleton
Street address of well location if in city: 1W 145

3 Owner of well: _____ Address: _____

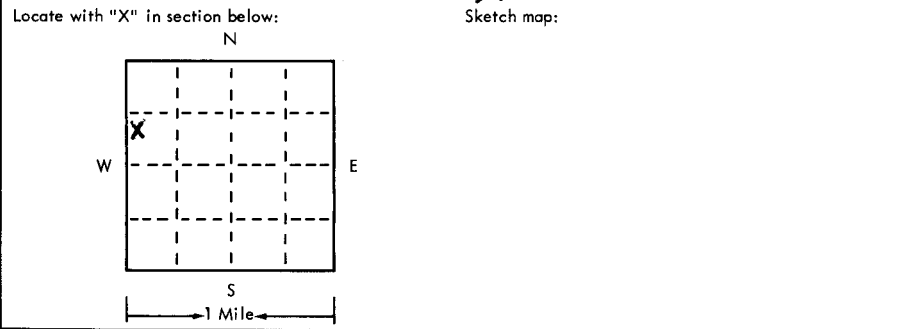

4 Well depth: 218 ft. Date of completion 5-27-75
Well diameter 8 in.
5 Cable tool Rotary Driven Dug
 Hollow rod Jetted Bored Reverse rotary
6 Use: Domestic Public supply Industry
 Irrigation Air conditioning Commercial
 Test well
7 Casing: Material Plastic Weight: above/below
Threaded Welded Surface 12 in.
Diam. _____ Weight _____ lbs./ft. _____
4 in. to 206 in. depth Drive shoe? Yes No
_____ in. to _____ ft. depth

2	Type and color of material	From	To
	GRAVEL, SANDY CLAY, SANDSTONE	80	86
	M, GRAVEL	86	112
	GRAVEL, CLAY, SANDSTONE	112	131
	M GRAVEL, SANDY CLAY	131	136
	GRAVEL, CLAY, SANDSTONE	136	146
	SANDSTONE	146	149
	GRAVEL, SANDSTONE	149	156
	HARD SANDSTONE	156	157
	GRAVEL, SANDSTONE	157	170
	CLAY, ROCK	170	174
	HARD SANDSTONE	174	177
	FINE SAND, SANDSTONE	177	194
	GRAVEL, CLAY, SANDSTONE	194	215
	GRAVEL	215	216
	Ochre	216	218

8 Screen: Manufacturer Jess + Lowell
Type Lucas Dia. 5
Slot/gauze 48 Length 12
Set between 206 ft. and 218 ft.
Fittings: Gravel pack Yes No Size range of material 48

9 Static water level: 94 ft. below land surface Date 5-27-75

10 Pumping level below land surfaces:
130 ft. after 3 hrs. pumping 20 g.p.m.
_____ ft. after _____ hrs. pumping _____ g.p.m.
Estimated maximum yield 50 g.p.m.

11 Water sample submitted: Yes No Date _____

12 Well head completion: Pitless adapter Inches above grade

13 Well grouted? Yes No
 Neat cement Bentonite _____
Depth: From 0 ft. to 10 ft.

14 Nearest source of possible contamination:
ft. _____ Direction _____ Type None
Well disinfected upon completion? Yes No

15 Pump: Not installed
Manufacturer's name _____
Model number _____ HP _____ Volts _____
Length of drop pipe _____ ft. capacity _____ g.m.p.
Type:
 Submersible Turbine
 Jet Reciprocating
 Centrifugal Other

16 Remarks: elevation 3810 (TOD)
Topography: Hill Slope Upland Valley

17 Water well contractor's certification:
This well was drilled under my jurisdiction and this report is true to the best of my knowledge and belief.
S & H Drilling Co. Inc. 166
Business name License No. _____
Address Headland Kansas
Signed Bill Johnson Date 6-3-75
Authorized representative