USE TYPEWRITER OR BALL POINT PEN-PRESS FIRMLY, PRINT CLEARLY.

WATER WELL RECORD
KSA 82a-1201-1215

CAB

Kansas Department of Health and Environment-Division of Environment
(Water well Contractors)
Topeka, Kansas 66620

1. Location of well:	County	Fraction	Section number	Township number	Range number
	Sherman	NW NE 1/4 SW 1/4	34	T 8 S	R 41 E/W

2. Distance and direction from nearest town or city: 2½ S 1/4 E OF
Street address of well location if in city: RULETON, KANS.

3. Owner of well: Clem Reitmayer
Rt. or street: City
City, state, zip code: QUINTER, KANSAS 67752

4. Locate with "X" in section below:

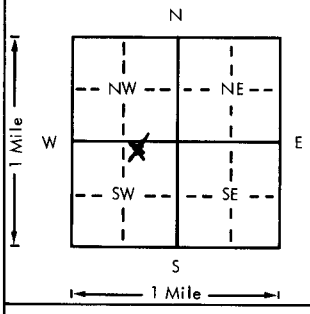

Sketch map:

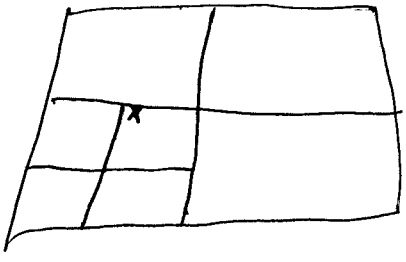

6. Bore hole dia. 24 in. Completion date 10-2-78
Well depth 302 ft.

7. __ Cable tool __ Rotary __ Driven __ Dug
__ Hollow rod __ Jetted __ Bored X Reverse rotary

8. Use: __ Domestic __ Public supply __ Industry
X Irrigation __ Air conditioning __ Stock
__ Lawn __ Oil field water __ Other

9. Casing: Material Steel Height: (Above) or below
Threaded ___ Welded X Surface 12 in.
RMP ___ PVC ___ Weight 27 lbs./ft.
Dia. 16 in. to 202 ft. depth Wall Thickness: inches or
Dia. 16 in. to 202 ft. depth gage No. .188

10. Screen: Manufacturer's name W.A. Brown
Type Keypunch Dia. 16"
(Slot) gauze 1/32 Length 100'
Set between 202 ft. and 302 ft.
___ ft. and ___ ft.
Gravel pack? X Size range of material 1/2 To 5/16"

11. Static water level: mo./day/yr.
160 ft. below land surface Date 9-27-79

12. Pumping level below land surfaces:
270 ft. after 16 hrs. pumping 450 g.p.m.
___ ft. after ___ hrs. pumping ___ g.p.m.
Estimated maximum yield 500 g.p.m.

13. Water sample submitted: mo./day/yr.
__ Yes X No Date

14. Well head completion:
__ Pitless adapter NC inches above grade

15. Well grouted? X
With: X Neat cement ___ Bentonite ___ Concrete
Depth: From 12" to 10 ft. below

16. Nearest source of possible contamination:
ft. ___ Direction ___ Type NONE
Well disinfected upon completion? ___ Yes X No

17. Pump: ___ Not installed
Manufacturer's name Goulds.
Model number 3J 40 HP 80 Volts ___
Length of drop pipe 280 ft. capacity 450 g.p.m.
Type:
__ Submersible X Turbine
__ Jet __ Reciprocating
__ Centrifugal __ Other

5. Type and color of material	From	To
Top Soil	0	3
Gravel & Sandyclay	3	133
Fine Sand	133	139
Sandyclay	139	165
Sand	165	176
Sandstone & Sandyclay	176	215
Sand	215	225
Sandstone	225	231
Sand	231	238
Sandstone	238	247
Sand	247	262
Sandstone	262	267
Gravel	267	287
Soapestone	287	293
Shale	293	294

(Use a second sheet if needed)

18. Elevation:
Topography:
__ Hill
X Slope
__ Upland
__ Valley

19. Remarks:
Concrete was Run
By Foust Supply Co Inc.

20. Water well contractor's certification:
This well was drilled under my jurisdiction and this report is true to the best of my knowledge and belief.
Foust Supply Co Inc. 144
Business name License No.
Address Box 338 Goodland Kans.
Signed [illegible] Mgr. Date 10-25
Authorized representative

T 8 R 41 E/W Sec 34 1/4 1/4 1/4 1/4

Forward the white, blue and pink copies to the Department of Health and Environment

Form WWC-5