


1 LOCATION OF WATER WELL: County: Sherman Fraction: NW 1/4 SW 1/4 NW 1/4 Section Number: 3 Township Number: T 8 S Range Number: R 42 E W

Distance and direction from nearest town or city street address of well if located within city?
1.5 of Kanorado

2 WATER WELL OWNER: Phil Laciay
 RR#, St. Address, Box #: 506 Walnut St.
 City, State, ZIP Code: Kanorado KS 67741
 Board of Agriculture, Division of Water Resources
 Application Number:

3 LOCATE WELL'S LOCATION WITH AN "X" IN SECTION BOX:

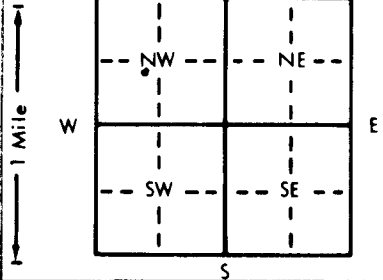

4 DEPTH OF COMPLETED WELL: 220 ft. ELEVATION: 130 ft.

 WELL WATER TO BE USED AS:
 1 Domestic 3 Feedlot 6 Oil field water supply 9 Dewatering 12 Other (Specify below)
 2 Irrigation 4 Industrial 7 Lawn and garden only 10 Monitoring well
 Was a chemical/bacteriological sample submitted to Department? Yes X No X If yes, mo/day/yr sample was submitted
 Water Well Disinfected? Yes No

5 TYPE OF BLANK CASING USED:
 1 Steel 3 RMP (SR) 5 Wrought iron 8 Concrete tile CASING JOINTS: Glued Clamped
 2 PVC 4 ABS 7 Fiberglass 9 Other (specify below) Welded
 Casing height above land surface 12 in., weight 160 lbs./ft. Wall thickness or gauge No. SDR26
 TYPE OF SCREEN OR PERFORATION MATERIAL:
 1 Steel 3 Stainless steel 5 Fiberglass 7 PVC 10 Asbestos-cement
 2 Brass 4 Galvanized steel 6 Concrete tile 9 ABS 11 Other (specify) 12 None used (open hole)
 SCREEN OR PERFORATION OPENINGS ARE:
 1 Continuous slot 3 Mill slot 5 Gauzed wrapped 8 Saw cut 11 None (open hole)
 2 Louvered shutter 4 Key punched 6 Wire wrapped 9 Drilled holes
 3 Torch cut 10 Other (specify)


 What is the nearest source of possible contamination:
 1 Septic tank 4 Lateral lines 7 Pit privy 10 Livestock pens 14 Abandoned water well
 2 Sewer lines 5 Cess pool 8 Sewage lagoon 11 Fuel storage 15 Oil well/Gas well
 3 Watertight sewer lines 6 Seepage pit 9 Feedyard 12 Fertilizer storage 16 Other (specify below)
 13 Insecticide storage

Direction from well? 200' West How many feet?

FROM	TO	LITHOLOGIC LOG	FROM	TO	PLUGGING INTERVALS
0	150	Gravel			
150	200	Sand + Clay			
200	220	Sand			
	220	Shale			

7 CONTRACTOR'S OR LANDOWNER'S CERTIFICATION: This water well was (1) constructed (2) reconstructed, or (3) plugged under my jurisdiction and was completed on (mo/day/year) 5-30-96 and this record is true to the best of my knowledge and belief. Kansas Water Well Contractor's License No. 284 This Water Well Record was completed on (mo/day/yr) 6-11-96 under the business name of Schaal Drilling, Co. by (signature) Robert Schaal

OFFICE USE ONLY
T
R
EW
SEC.
1/4
1/4
1/4