


1 LOCATION OF WATER WELL: County: SHERMAN	Fraction: $\frac{1}{4}$ SE $\frac{1}{4}$ SE $\frac{1}{4}$	Section Number: (4) 4	Township Number: T 8 (8) S	Range Number: R 42 (42) E(W)
---	---	------------------------------	-----------------------------------	-------------------------------------

Distance and direction from nearest town or city street address of well if located within city?

Kanorado Kanis. Kanorado, Kansas

2 WATER WELL OWNER: RR#, St. Address, Box # : JOHN T. NELSON Kanorado	John T. Nelson, Rt 1, Box 133 Kanorado, Kas. 67741
City, State, ZIP Code : Kanis, 67741	Board of Agriculture, Division of Water Resources Application Number:

3 LOCATE WELL'S LOCATION WITH AN "X" IN SECTION BOX:

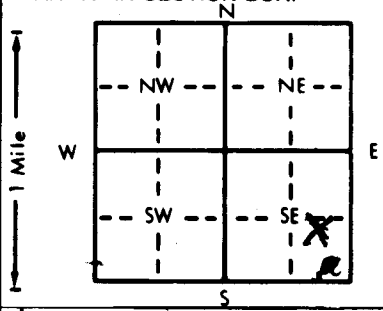

4 DEPTH OF COMPLETED WELL: 135 ft. ELEVATION:	Depth(s) Groundwater Encountered: none ft. 2. ft. 3. ft.
WELL'S STATIC WATER LEVEL: none ft. below land surface measured on mo/day/yr	Pump test data: Well water was ft. after hours pumping gpm
Est. Yield gpm: Well water was ft. after hours pumping gpm	Bore Hole Diameter in. to ft., and in. to ft.
WELL WATER TO BE USED AS:	5 Public water supply 8 Air conditioning 11 Injection well
(1) Domestic 3 Feedlot 6 Oil field water supply 9 Dewatering 12 Other (Specify below)	2 Irrigation 4 Industrial 7 Lawn and garden only 10 Observation well
Was a chemical/bacteriological sample submitted to Department? Yes.....No.....; If yes, mo/day/yr sample was submitted	Water Well Disinfected? Yes No

5 TYPE OF BLANK CASING USED:	5 Wrought iron	8 Concrete tile	CASING JOINTS: Glued Clamped
1 Steel 3 RMP (SR)	6 Asbestos-Cement	9 Other (specify below)	Welded
2 PVC 4 ABS	7 Fiberglass		Threaded
Blank casing diameter in. to ft., Dia in. to ft., Dia in. to ft.	Casing height above land surface in., weight lbs./ft. Wall thickness or gauge No.		
TYPE OF SCREEN OR PERFORATION MATERIAL:		7 PVC	10 Asbestos-cement
1 Steel 3 Stainless steel	5 Fiberglass	8 RMP (SR)	11 Other (specify)
2 Brass 4 Galvanized steel	6 Concrete tile	9 ABS	12 None used (open hole)
SCREEN OR PERFORATION OPENINGS ARE:		5 Gauzed wrapped	8 Saw cut 11 None (open hole)
1 Continuous slot 3 Mill slot	6 Wire wrapped	9 Drilled holes	
2 Louvered shutter 4 Key punched	7 Torch cut	10 Other (specify)	
SCREEN-PERFORATED INTERVALS:		From ft. to ft., From ft. to ft.	
GRAVEL PACK INTERVALS:		From ft. to ft., From ft. to ft.	

6 GROUT MATERIAL:	1 Neat cement	2 Cement grout	3 Bentonite	4 Other
Grout Intervals: From ft. to ft., From ft. to ft., From ft. to ft.				
What is the nearest source of possible contamination:		10 Livestock pens	14 Abandoned water well	
1 Septic tank 4 Lateral lines	7 Pit privy	11 Fuel storage	15 Oil well/Gas well	
2 Sewer lines 5 Cess pool	8 Sewage lagoon	12 Fertilizer storage	16 Other (specify below)	
3 Watertight sewer lines 6 Seepage pit	9 Feedyard	13 Insecticide storage	none	
Direction from well?		How many feet?		

FROM	TO	LITHOLOGIC LOG	FROM	TO	LITHOLOGIC LOG
		no water no water			
135		gravel gravel			
135		cemented July 14, 1988			

7 CONTRACTOR'S OR LANDOWNER'S CERTIFICATION: This water well was (1) constructed, (2) reconstructed, or (3) plugged under my jurisdiction and was completed on (mo/day/year) July 14, 1988 and this record is true to the best of my knowledge and belief. Kansas Water Well Contractor's License No. This Water Well Record was completed on (mo/day/yr) July 16, 1988 under the business name of John T. Nelson by (signature) John T. Nelson
--

INSTRUCTIONS: Use typewriter or ball point pen. PLEASE PRESS FIRMLY and PRINT clearly. Please fill in blanks, underline or circle the correct answers. Send top three copies to Kansas Department of Health and Environment, Bureau of Water Protection, Topeka, Kansas 66620-7320, Telephone: 913-862-9360. Send one to WATER WELL OWNER and retain one for your records.

Freda Nelson

OFFICE USE ONLY

T

R

EW

SEC

1/4

1/4

1/4